

ADDENDUM F (NON-DSA APPROVAL)

**HAMMEL, GREEN AND ABRAHAMSON, INC.,
ARCHITECTS & ENGINEERS**
1918 Main Street, Third Floor
Santa Monica, CA 90405

PROJECT: Santa Ana College
Science Center

DATE: 8/31/2017

OWNER: RSCCD
2323 N. Broadway, Suite 112
Santa Ana, CA 92706

DSA File No.: 30-C2
DSA Applications No.: 04-115788
HGA Commission No.: 3584-001-00

CONSTRUCTION MANAGER:

BERNARDS
3633 E. Inland Empire Blvd., Suite 800
Ontario, CA 91764

The additions, revisions, omissions, corrections and clarifications contained herein shall be made to drawings and specifications for the project and shall be included in scope of work and bids to be submitted. Additionally, reference documents, such as as-built documentation of existing buildings, are provided to further quantify the scope of work. References made below to specifications, drawings, and other documents shall be used as a general guide only. Bidders and Contractors shall determine for themselves the work affected by Addendum items.

RFP

Item AD-F-1 – Revise RFP Schedule on Page 2 as follows (changes noted in **red**):

Event / Occurrence	Deadline
District Issues RFP & Contract Documents Available	July 26, 2017
Pre-bid Conference (Mandatory for General Contractors)	August 2, 2017 @ 9:00AM
Deadline for Contractors to submit questions regarding this RFP	September 13 , 2017 @ 4:00PM
Deadline for MEP subcontractors to submit prequalification package	August 10, 2017 @ 4:00PM
District to provide list of all prequalified MEP subcontractors	August 31 , 2017
Deadline for District to issue final addendum (72 hours before date for Proposal submission)	September 29 , 2017 @ 12:00PM
Deadline for Contractors to submit Proposal	October 4 , 2017 @ 12:00PM
District to interview some Contractor(s) (Optional)	October 10, 2017 and/or October 11, 2017 (Anticipated)
District to finalize recommendation for District Board of Trustees	No Later than October 20, 2017 (Anticipated)
District Board of Trustees approves successful Contractor	November 13, 2017 (Anticipated)

Item AD-F-2 – Add Workbook TAB IX to Section 1.1.1 as follows:

Workbook Tab IX – Scoping Sheets

Provide a scoping sheet for each work category or bid package. Include within the scoping sheet all scope required to be covered by the subcontractor (or contractor if self-performed) and that the selected subcontractor has included all necessary scope items. In addition, indicate all exclusions and allowances. Contractor does not need to indicate any other subcontractor’s proposal/bid information other than the subcontractor selected for the scope of work. If Contractor is self-performing the scope of work, Contractor shall include at least two (2) bona fide proposals/bids from unassociated subcontractors to perform the same scope of work within the sheet, in accordance with Workbook Tab a.2.

Item AD-F-3 – Revise Attachment 6

- GMP Workbook Template to include TAB IX as indicated in Item AD-F-1 above. Please use the link below to download the most current Excel version of the GMP Workbook Template.

<https://www.dropbox.com/s/lzwxnj4xetj5wrd/170831-RSCCD-TEMPLATE-GMP%20V6.XLS?dl=0>

Item AD-F-4 – Prequalified Subcontractor Shortlist

- Refer to attachment AD-F-4 for the prequalified subcontractor shortlist.

SPECIFICATIONS

None

DRAWINGS

None

RESPONSES TO PRE-BID CLARIFICATION (“PBC”)

Item AD-F-5 – Response to the following PBCs

- PBC 15 through PBC 43
- PBC 45 through PBC 49
- PBC 51 through PBC 72

Attachments:

AD-F-4 (1 sheet)

AD-F-5 (59 sheets)

END OF ADDENDUM F

C-7

Advanced Cable Solutions
Digital Network Group, Inc.
Telenet VoIP, Inc.

C-10

Advanced Cable Solutions
Baker Electric
Climatec, LLC
Comet Electric Inc
Digital Network Group, Inc.
Gilbert & Sterns, Inc.
Mel Smith Electric, Inc.
Morrow-Meadows Corporation
Neubauer Electric Inc.
G A Abell, Inc dba Precision Electric Company
RDM Electric Co., Inc.
Rosendin Electric, Inc.
Sheldon Mechanical Corporation

C-16

Bali Construction Inc.
Daart Engineering Company, Inc.
J.G. Tate Fire Protection Systems, Inc.
Kincaid Industries, Inc.

C-20

Able Heating & Air Conditioning, Inc.
Acco Engineered Systems
ACH Mechanical Contractors
Air-Ex Air Conditioning, Inc.
Alpha Mechanical Inc
Circulating Air, Inc.
Climatec, LLC
Control Air Conditioning Corporation
Couts Heating & Cooling
Eberhard
Jackson & Blanc
Limbach Company LP
Southland Industries
University Mechanical & Engineering Contractors, Inc.
Westland Heating & Air Conditioning, Inc.
XCEL Mechanical Systems, Inc.

C-34

Interpipe Contracting, Inc.
Murray Company Mechanical Contractors

C-36

Acco Engineered Systems
Alpha Mechanical Inc
Bali Construction Inc.
City Commercial Plumbing, Inc.
Empyrean Plumbing, Inc.
HL Moe Co., Inc.
Interpipe Contracting, Inc.
Kincaid Industries, Inc.
Murray Company Mechanical Contractors
Pro-Craft Construction, Inc.
Southland Industries
University Mechanical & Engineering Contractors, Inc.

C-43

Best Contracting Services
Cimco A/C & Sheet Metal, Inc.
Crown Sheet Metal Products, Inc
Eberhard
Letner Roofing Company
RB Sheet Metal Inc
Valencia Sheet Metal

Attachment 4**PRE-BID CLARIFICATION ("PBC") FORM
(ALL questions to be submitted on this form ONLY)**PBC # **15**
(RSCCD USE ONLY):

PROJECT NAME:	RFP #1718-173 Science Center at Santa Ana College		
PROJECT NUMBER:	3049	DSA NUMBER:	04-115788
TO:	Allison Coburn	EMAIL:	Coburn_Allison@rsccd.edu

DATE:	August 7th, 2017		
FROM:	Luis Giordano McCarthy Building Companies	EMAIL:	lgiordano@mccarthy.com
SPECIFICATION NUMBER:	032000; 031500; 031100	DRAWING NUMBER:	
REQUESTED CLARIFICATION:			
<p>Specification Section 031500 – Concrete Accessories references Related Section 032000 Concrete Reinforcing (031500-1.1B.2), however this Specification Section is not provided. Also Section 031500-3.1A indicates to install concrete accessories and related materials as specified in Section 031100 – Concrete Formwork and this specification is also not provided. Please provide both missing specifications.</p>			
RESPONSE TO CLARIFICATION, SUBMITTED AS PART OF AN ADDENDUM:			
<p>Specification Sections 031100 and 032000 are not included in this package, as the information for reinforcing and formwork is included in Section 033000.</p> <p>Forthcoming Addendum 2 will correct the incorrect spec section references noted above.</p>			
RESPONSE PROVIDED BY:	Stacy Kwok/ HGA	DATE:	8/31/17

Attach additional numbered sheets as necessary; however, only one (1) request shall be contained on each submitted form.

Attachment 4

**PRE-BID CLARIFICATION ("PBC") FORM
(ALL questions to be submitted on this form ONLY)**

PBC # **16**
(RSCCD USE ONLY):

PROJECT NAME:	RFP #1718-173 Science Center at Santa Ana College		
PROJECT NUMBER:	3049	DSA NUMBER:	04-115788
TO:	Allison Coburn	EMAIL:	Coburn_Allison@rsccd.edu

DATE:	August 7th, 2017		
FROM:	Luis Giordano McCarthy Building Companies	EMAIL:	lgiordano@mccarthy.com

SPECIFICATION NUMBER:	032000; 031500; 031100	DRAWING NUMBER:	
-----------------------	------------------------	-----------------	--

REQUESTED CLARIFICATION:

Specification Section 031500 – Concrete Accessories references Related Section 032000 Concrete Reinforcing (031500-1.1B.2), however this Specification Section is not provided. Also Section 031500-3.1A indicates to install concrete accessories and related materials as specified in Section 031100 – Concrete Formwork and this specification is also not provided. Please provide both missing specifications.

RESPONSE TO CLARIFICATION, SUBMITTED AS PART OF AN ADDENDUM:

Specification Sections 031100 and 032000 are not included in this package, as the information for reinforcing and formwork is included in Section 033000.

Forthcoming Addendum 2 will correct the incorrect spec section references noted above.

RESPONSE PROVIDED BY:	Stacy Kwok/ HGA	DATE:	8/31/17
-----------------------	-----------------	-------	---------

Attach additional numbered sheets as necessary; however, only one (1) request shall be contained on each submitted form.

Attachment 4

**PRE-BID CLARIFICATION ("PBC") FORM
(ALL questions to be submitted on this form ONLY)**

PBC # **17**
(RSCCD USE ONLY):

PROJECT NAME:	RFP #1718-173 Science Center at Santa Ana College		
PROJECT NUMBER:	3049	DSA NUMBER:	04-115788
TO:	Allison Coburn	EMAIL:	Coburn_Allison@rsccd.edu

DATE:	August 7th, 2017		
FROM:	Luis Giordano McCarthy Building Companies	EMAIL:	lgiordano@mccarthy.com
SPECIFICATION NUMBER:	033000	DRAWING NUMBER:	S2.01

REQUESTED CLARIFICATION:

On sheet S2.01 in the pile cap symbol where it indicates the top of footing elevation relative to the lowest adjacent top of slab elevation, all but one have a '-' indicating the depth of the top of footing. Please confirm that all the top of footings are to be located at 1'-6" below top of slab.

RESPONSE TO CLARIFICATION, SUBMITTED AS PART OF AN ADDENDUM:

All top of footings are to be located at -1'-6" (from the slab on grade), except the pile cap at 2/B-C.

RESPONSE PROVIDED BY:	Saif Haroon	DATE:	08/31/17
-----------------------	-------------	-------	----------

Attach additional numbered sheets as necessary; however, only one (1) request shall be contained on each submitted form.

Attachment 4

**PRE-BID CLARIFICATION ("PBC") FORM
(ALL questions to be submitted on this form ONLY)**

PBC # **18**
(RSCCD USE ONLY):

PROJECT NAME:	RFP #1718-173 Science Center at Santa Ana College		
PROJECT NUMBER:	3049	DSA NUMBER:	04-115788
TO:	Allison Coburn	EMAIL:	Coburn_Allison@rsccd.edu

DATE:	August 7th, 2017		
FROM:	Luis Giordano McCarthy Building Companies	EMAIL:	lgiordano@mccarthy.com
SPECIFICATION NUMBER:	033000	DRAWING NUMBER:	S2.01 - S3.02

REQUESTED CLARIFICATION:

On sheet S2.01 at GL 4 between GL E & F the Pile cap is labeled as PC3, however on sheet S3.02 there is no PC3 in the schedule. Please advise if this should be labeled PC3A or PC3B?

RESPONSE TO CLARIFICATION, SUBMITTED AS PART OF AN ADDENDUM:

PC3 SHOULD BE REPLACED BY PC3A.

RESPONSE PROVIDED BY:	Saif Haroon	DATE:	08/31/17
-----------------------	-------------	-------	----------

Attach additional numbered sheets as necessary; however, only one (1) request shall be contained on each submitted form.

Attachment 4

**PRE-BID CLARIFICATION ("PBC") FORM
(ALL questions to be submitted on this form ONLY)**

PBC # **19**
(RSCCD USE ONLY):

PROJECT NAME:	RFP #1718-173 Science Center at Santa Ana College		
PROJECT NUMBER:	3049	DSA NUMBER:	04-115788
TO:	Allison Coburn	EMAIL:	Coburn_Allison@rsccd.edu

DATE:	August 7th, 2017		
FROM:	Luis Giordano McCarthy Building Companies	EMAIL:	lgiordano@mccarthy.com
SPECIFICATION NUMBER:	033000	DRAWING NUMBER:	S3.02

REQUESTED CLARIFICATION:


Detail 1/S3.02 there is a pile cap labeled PC6, however on the plans there is no PC6. Please confirm this pile cap should be PC6B in the schedule.

RESPONSE TO CLARIFICATION, SUBMITTED AS PART OF AN ADDENDUM:

Please see attached mark ups to clarify the pile cap designations. Will be updated in the Addendum #2 drawings.

RESPONSE PROVIDED BY:	Saif Haroon	DATE:	08/31/17
-----------------------	-------------	-------	----------

Attach additional numbered sheets as necessary; however, only one (1) request shall be contained on each submitted form.

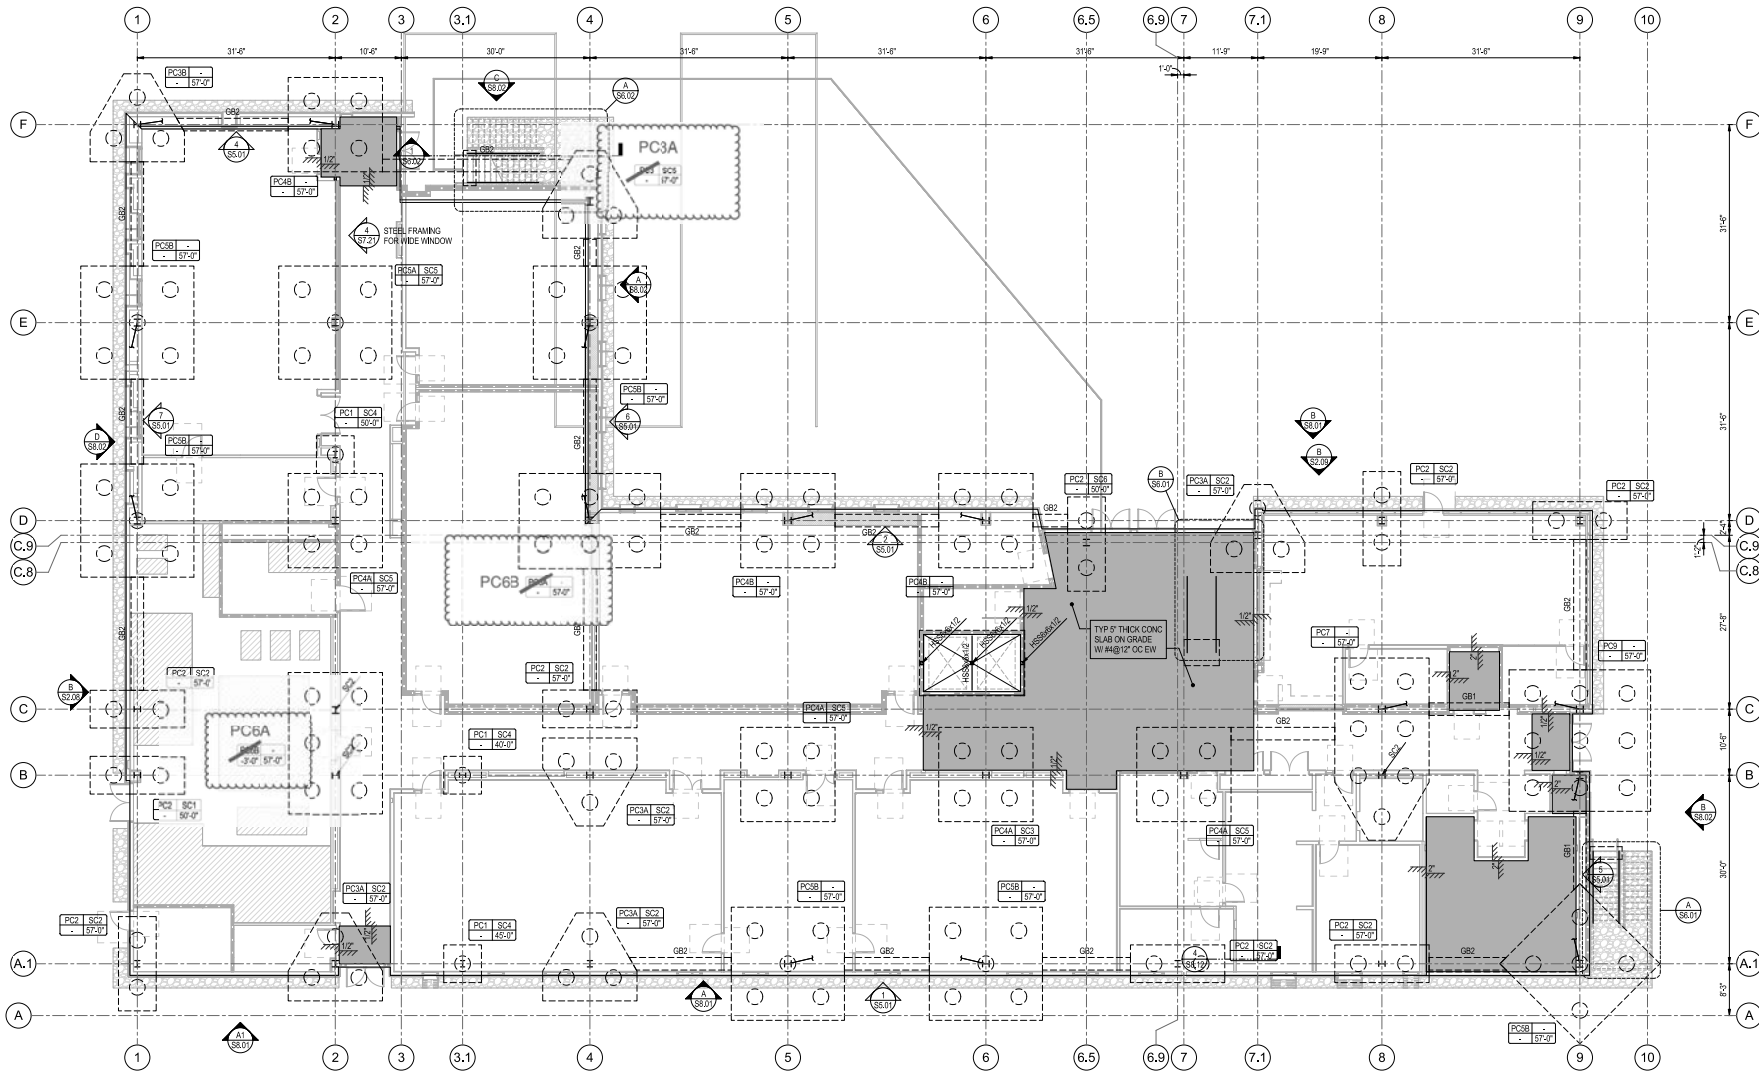

1 LEVEL 01 FOUNDATION PLAN
1/8" = 1'-0"

FOUNDATION PLAN NOTES

- FOR GENERAL NOTES SEE S&UX SERIES SHEETS. TYPICAL DETAILS OCCUR THROUGHOUT THESE STRUCTURAL DRAWINGS IN ADDITION TO THOSE ON S&UX SERIES SHEETS.
- VERIFY CONC. SLAB ELEVATIONS INCLUDING SLAB DEPRESSIONS, SLOPES, OPENINGS, CURBS, DRAINS, TRENCHES, & SLAB EDGE LOCATIONS, & WALL OVERALL DIMENSIONS INCLUDING LOCATIONS OF OPENINGS WITH ARCHITECTURAL DWGS.
- SEE ARCHITECTURAL DWGS FOR REMAINDER OF DIMENSIONS & ELEVATIONS NOT SHOWN ON STRUCT DWGS. VERIFY ALL DIMENSIONS & ELEVATIONS W/ ARCHITECTURAL DWGS PRIOR TO START OF WORK.
- PERFORM EXCAVATION WORK IN COMPLIANCE WITH CALIFORNIA REGULATIONS.
- FOUNDATION EXCAVATIONS MUST BE OBSERVED AND APPROVED BY PROJECT GEOTECHNICAL CONSULTANT PRIOR TO PLACING REINFORCING STEEL.
- LOCATE NEW SUBGRADE UTILITIES AS INDICATED ON STRUCT AND MEP DRAWINGS. IDENTIFY LOCATIONS AND INVERT ELEVATIONS OF AFFECTED EXISTING UTILITIES PRIOR TO START OF WORK. NOTIFY ARCHITECT AND SEOR/P. LOCATIONS ARE OTHER THAN AS NOTED, OR REQUIRE ADDITIONAL FIELD CONSTRUCTION, OR EXCAVATION BELOW NOTED LIMIT LINES. DO NOT PENETRATE EXISTING STRUCTURE OR EXCAVATE BELOW EXISTING OR NEW FOUNDATIONS WITHOUT APPROVAL OF SEOR.
- CENTER COLUMNS ON GRIDLINES UNL.
- TOP OF GRADE BEAM & CONTINUOUS FOOTING ELEVATIONS TO MATCH TOP OF PILE CAP OR SPREAD FOOTING ELEVATION EA END, UNLESS NOTED OTHERWISE, THUS, "XXX".
- TYPICAL CONC. SLAB ON GRADE SHALL BE AS FOLLOWS UNLESS NOTED OTHERWISE: 5" THICK CONC. SLAB W/ #4@12" EA WAY AT CENTER OF SLAB. PROVIDE VAPOR BARRIER AND SUBGRADE REQUIREMENTS PER SOBS REPORT.
- PROVIDE CONSTRUCTION JOINTS AND CONTROL JOINTS IN CONC. SLAB ON GRADE PER 1 / 90.11 AND AS REQ'D PER ARCHITECTURAL DWGS.
- PROVIDE STRUCTURAL STEEL FRAMING (INCLUDING DIM'DER BEAMS) TO SUPPORT ELEVATOR GUIDEWAYS AND ELEVATOR COUNTERWEIGHTS PER 1 / 90.40.

FOUNDATION PLAN SYMBOLS

PLAN SYMBOL	DESCRIPTION	DETAIL/ SCHED
	INDICATES PILECAP TYPE MARK, SEE SCHEDULE 1 / S3.02 INDICATES COLUMN TYPE MARK, SEE SCHEDULE 1 / S4.01 INDICATES LENGTH OF FILE FROM BOTTOM OF PILE CAP	
	INDICATES TOP OF FOOTING ELEVATION RELATIVE TO THE LOWEST ADJACENT TOP OF CONCRETE SLAB OR FINISHED GRADE ELEVATION (+1'-0" MIN UNL), VERIFY W/ ARCH.	
	INDICATES GRADE BEAM MARK	3 S3.01
	INDICATES STEPPED FOOTING / GRADE BM	2 S3.01
	INDICATES CONCRETE PAD	3 S3.01
	INDICATES SLAB DEPRESSION VERIFY W/ ARCH	

HGA
1518 Main Street Third Floor
Santa Monica, California 90405
Telephone 310.587.7600

STRUCTURAL ENGINEER
SAPUL BROCKETT
155 N LAKE AVE
PASADENA, CA 91101
626-304-9116

MECHANICAL & PLUMBING ENGINEER
STANTEC CONSULTING INC
14120 RIVERSIDE DR., 201
SHERMAN OAKS, CA 91423
818-377-8220

ELECTRICAL ENGINEER
FSA ENGINEERING
150 PAULARINO AVE., #A120
COSTA MESA, CA 92626
949-262-0265

CIVIL ENGINEER
KPFF CONSULTING ENGINEERS
700 SOUTH FLOWER ST., #2100
LOS ANGELES, CA 90017
213-418-0201

LANDSCAPE ARCHITECT
LYNN CAPOVIA, INC.
17902 MITCHELL SOUTH, #110
IRVINE, CA 92614
949-756-1510

LABORATORY CONSULTANT
RESEARCH FACILITIES DESIGN
3965 76TH AVE., #400
SAN DIEGO, CA 92103
619-297-0159

SCIENCE CENTER
SANTA ANA COLLEGE
RANCHO SANTIAGO
COMMUNITY COLLEGE
DISTRICT
1530 W. 17TH ST.
SANTA ANA, CA 92706





NO.	DESCRIPTION	DATE

DESIGNED BY: [Signature] CHECKED BY: [Signature]
HGA NO: 3584-001-00

FIRST LEVEL FOUNDATION PLAN

DATE: JULY 06, 2017


S2.01
DSA APPROVAL SET

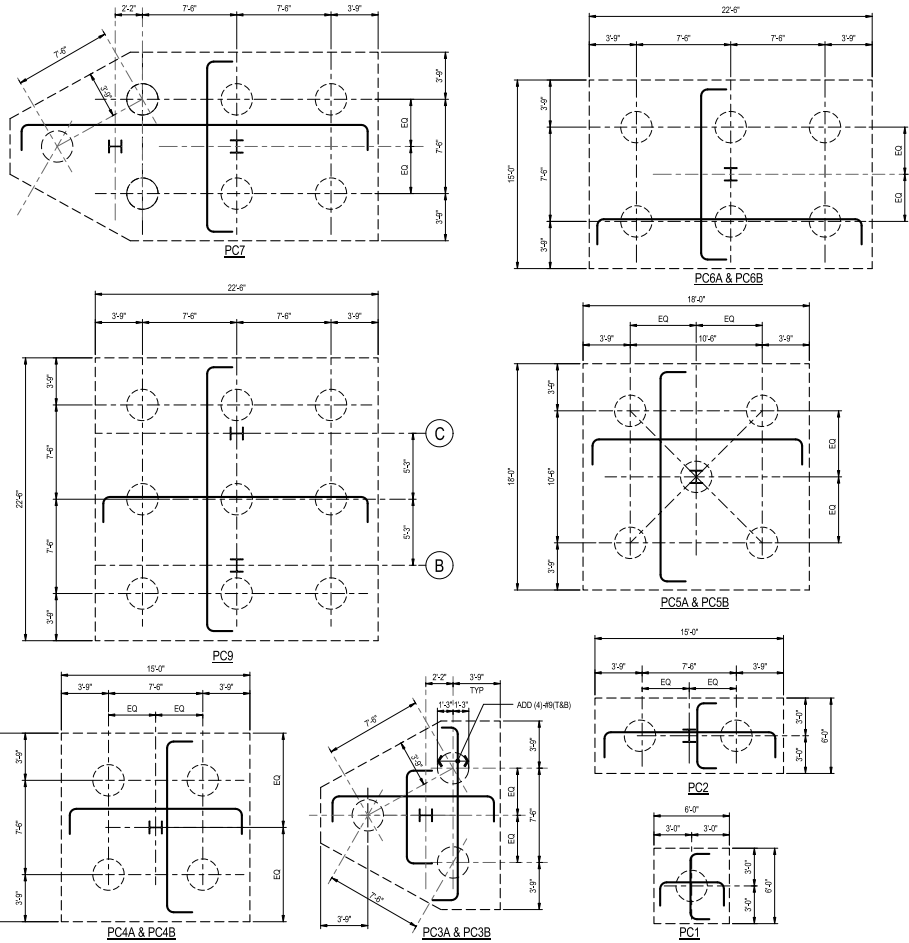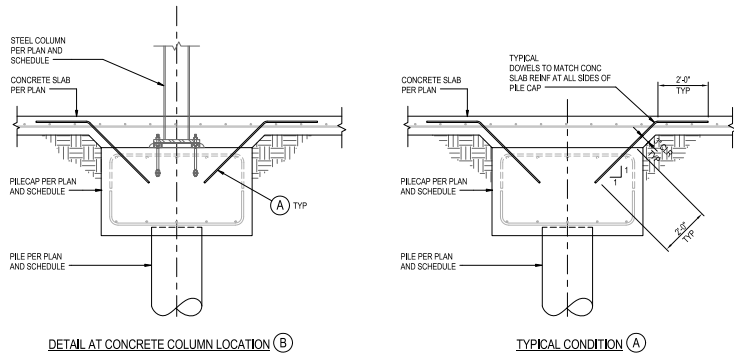

3 TYPICAL STRUCTURAL SLAB ON GRADE TO PILE CAP CONNECTION DETAILS

PILE ALLOWABLE CAPACITY TABLE		
PILE DEPTH (FT)	DOWNWARD CAPACITY (KIPS)	UPWARD CAPACITY (KIPS)
50	112	-
57	136	82

NOTE: DOWNWARD AND UPWARD CAPACITIES CAN BE INCREASED BY 33% FOR SEISMIC AND WIND LOADING.

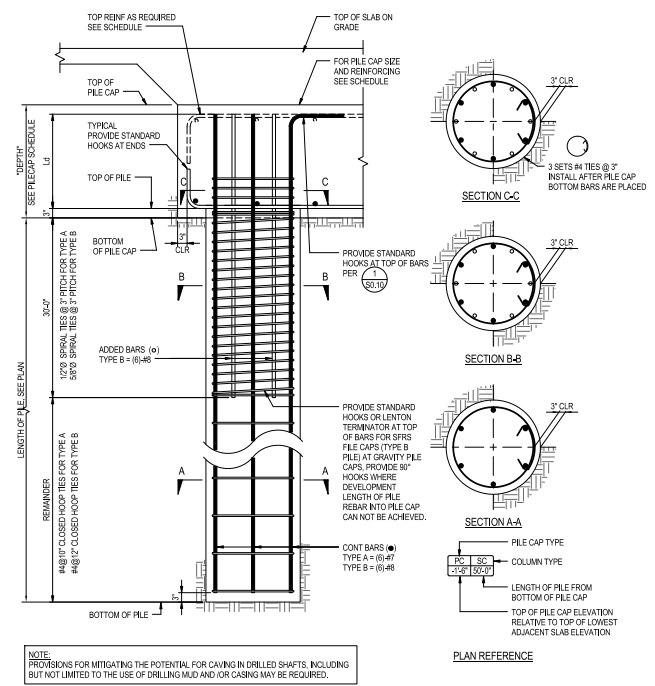

2 TYPICAL 30" DIAMETER PILE AND PILE CAP ELEVATION AND SECTIONS

1 TYPICAL PILE CAP DETAILS

MARK	PILE SIZE	NUMBER OF PILES	PILE TYPE	DEPTH (ft)	REINFORCING		REMARKS
					LONGITUDINAL	TRANSVERSE	
PC1	6'-0"x6'-0"	1	A	36	#6@12(T&B)	#6@12(T&B)	FOR PILE AND PILE CAP ELEVATION AND SECTION SEE S107
PC2	15'-0"x6'-0"	2	A	36	#6@12(T) #10@12(B)	#6@12(T&B)	
PC3A	-	3	A	36	#6@12(T) #9@12(B)	#6@12(B)	
PC3B	-	3	B	54	#6@12(T) #9@12(B)	#6@12(T)	
PC4A	15'-0"x15'-0"	4	A	36	#6@12(T) #9@12(B)	#6@12(T)	
PC4B	15'-0"x15'-0"	4	B	54	#6@12(T) #9@12(B)	#6@12(T)	
PC5A	18'-0"x18'-0"	5	A	36	#6@12(T) #9@12(B)	#6@12(T)	
PC5B	18'-0"x18'-0"	5	B	54	#6@12(T) #10@12(B)	#6@12(T)	
PC6A	15'-0"x22'-6"	6	A	48	#6@12(T) #9@12(B)	#6@12(T)	
PC7	15'-0"x22'-6"	7	B	60	#11@12(T&B)	#11@12(T&B)	
PC9	22'-6"x22'-6"	9	B	60	#11@12(T&B)	#11@12(T&B)	

HGA
1518 Main Street Third Floor
Santa Monica, California 90405
Telephone 310.517.7800

STRUCTURAL ENGINEER
SAPUL BOUQUET
155 N LAKE AVE
PASADENA, CA 91101
626-304-9116

MECHANICAL & PLUMBING ENGINEER
STANTEC CONSULTING INC
1430 RIVERSIDE DR. # 201
SHERMAN OAKS, CA 91423
818-377-8220

ELECTRICAL ENGINEER
FSA ENGINEERING
150 PAULARINO AVE. #A120
COSTA MESA, CA 92626
949-552-9995

CIVIL ENGINEER
KPFF CONSULTING ENGINEERS
700 SOUTH FLOWER ST. #2100
LOS ANGELES, CA 90017
213-418-0201

LANDSCAPE ARCHITECT
LYNN CAPOVIA, INC.
17992 MITCHELL SOUTH, #110
EVANES, CA 92614
949-756-1510

LABORATORY CONSULTANT
RESEARCH FACILITIES DESIGN
3965 16TH AVE. #400
SAN DIEGO, CA 92103
619-297-0199

**SCIENCE CENTER
SANTA ANA COLLEGE**
RANCHO SANTIAGO
COMMUNITY COLLEGE
DISTRICT
1530 W. 17TH ST.
SANTA ANA, CA 92706

SANTA ANA COLLEGE

UNIVERSITY OF CALIFORNIA, SANTA ANA
SANTA ANA COLLEGE DISTRICT
1530 W. 17TH STREET
SANTA ANA, CA 92706
TEL: 714.242.3000
WWW.SACEDUCATION.COM

MADE POSSIBLE BY
THE UNIVERSITY OF CALIFORNIA
SANTA ANA COLLEGE DISTRICT

NO.	DESCRIPTION	DATE

DESIGNED BY: [Signature] DATE: [Date]
DRAWN BY: [Signature] DATE: [Date]

HGA NO: 3584-001-00

**FOUNDATION
SCHEDULE AND
TYPICAL
DETAILS**

DATE: JULY 06, 2017

S3.02

Attachment 4

**PRE-BID CLARIFICATION ("PBC") FORM
(ALL questions to be submitted on this form ONLY)**

PBC # **20**
(RSCCD USE ONLY):

PROJECT NAME:	RFP #1718-173 Science Center at Santa Ana College		
PROJECT NUMBER:	3049	DSA NUMBER:	04-115788
TO:	Allison Coburn	EMAIL:	Coburn_Allison@rsccd.edu

DATE:	August 7th, 2017		
FROM:	Luis Giordano McCarthy Building Companies	EMAIL:	lgiordano@mccarthy.com

SPECIFICATION NUMBER:	032000; 031500; 031100	DRAWING NUMBER:	
-----------------------	------------------------	-----------------	--

REQUESTED CLARIFICATION:

Specification Section 031500 – Concrete Accessories references Related Section 032000 Concrete Reinforcing (031500-1.1B.2), however this Specification Section is not provided. Also Section 031500-3.1A indicates to install concrete accessories and related materials as specified in Section 031100 – Concrete Formwork and this specification is also not provided. Please provide both missing specifications.

RESPONSE TO CLARIFICATION, **SUBMITTED AS PART OF AN ADDENDUM:**

Specification Sections 031100 and 032000 are not included in this package, as the information for reinforcing and formwork is included in Section 033000.

Forthcoming Addendum 2 will correct the incorrect spec section references noted above.

RESPONSE PROVIDED BY:	Stacy Kwok/ HGA	DATE:	8/31/17
-----------------------	-----------------	-------	---------

Attach additional numbered sheets as necessary; however, only one (1) request shall be contained on each submitted form.

Attachment 4

**PRE-BID CLARIFICATION ("PBC") FORM
(ALL questions to be submitted on this form ONLY)**

PBC # **21**
(RSCCD USE ONLY):

PROJECT NAME:	RFP #1718-173 Science Center at Santa Ana College		
PROJECT NUMBER:	3049	DSA NUMBER:	04-115788
TO:	Allison Coburn	EMAIL:	Coburn_Allison@rsccd.edu

DATE:	August 7th, 2017		
FROM:	Luis Giordano McCarthy Building Companies	EMAIL:	lgiordano@mccarthy.com

SPECIFICATION NUMBER:	032000; 031500; 031100	DRAWING NUMBER:	
-----------------------	------------------------	-----------------	--

REQUESTED CLARIFICATION:

Specification Section 031500 – Concrete Accessories references Related Section 032000 Concrete Reinforcing (031500-1.1B.2), however this Specification Section is not provided. Also Section 031500-3.1A indicates to install concrete accessories and related materials as specified in Section 031100 – Concrete Formwork and this specification is also not provided. Please provide both missing specifications.

RESPONSE TO CLARIFICATION, SUBMITTED AS PART OF AN ADDENDUM:

Specification Sections 031100 and 032000 are not included in this package, as the information for reinforcing and formwork is included in Section 033000.

Forthcoming Addendum 2 will correct the incorrect spec section references noted above.

RESPONSE PROVIDED BY:	Stacy Kwok/ HGA	DATE:	8/31/17
-----------------------	-----------------	-------	---------

Attach additional numbered sheets as necessary; however, only one (1) request shall be contained on each submitted form.

Attachment 4

**PRE-BID CLARIFICATION ("PBC") FORM
(ALL questions to be submitted on this form ONLY)**

PBC # **22**
(RSCCD USE ONLY):

PROJECT NAME:	RFP #1718-173 Science Center at Santa Ana College		
PROJECT NUMBER:	3049	DSA NUMBER:	04-115788
TO:	Allison Coburn	EMAIL:	Coburn_Allison@rsccd.edu

DATE:	August 7th, 2017		
FROM:	Luis Giordano McCarthy Building Companies	EMAIL:	lgiordano@mccarthy.com

SPECIFICATION NUMBER:	032000; 031500; 031100	DRAWING NUMBER:	
-----------------------	------------------------	-----------------	--

REQUESTED CLARIFICATION:

Specification Section 031500 – Concrete Accessories references Related Section 032000 Concrete Reinforcing (031500-1.1B.2), however this Specification Section is not provided. Also Section 031500-3.1A indicates to install concrete accessories and related materials as specified in Section 031100 – Concrete Formwork and this specification is also not provided. Please provide both missing specifications.

RESPONSE TO CLARIFICATION, SUBMITTED AS PART OF AN ADDENDUM:

Specification Sections 031100 and 032000 are not included in this package, as the information for reinforcing and formwork is included in Section 033000.

Forthcoming Addendum 2 will correct the incorrect spec section references noted above.

RESPONSE PROVIDED BY:	Stacy Kwok/ HGA	DATE:	8/31/17
-----------------------	-----------------	-------	---------

Attach additional numbered sheets as necessary; however, only one (1) request shall be contained on each submitted form.

Attachment 4

**PRE-BID CLARIFICATION ("PBC") FORM
(ALL questions to be submitted on this form ONLY)**

PBC # **23**
(RSCCD USE ONLY):

PROJECT NAME:	RFP #1718-173 Science Center at Santa Ana College		
PROJECT NUMBER:	3049	DSA NUMBER:	04-115788
TO:	Allison Coburn	EMAIL:	Coburn_Allison@rsccd.edu

DATE:	August 7th, 2017		
FROM:	Luis Giordano McCarthy Building Companies	EMAIL:	lgiordano@mccarthy.com

SPECIFICATION NUMBER:	032000; 031500; 031100	DRAWING NUMBER:	
-----------------------	------------------------	-----------------	--

REQUESTED CLARIFICATION:

Specification Section 031500 – Concrete Accessories references Related Section 032000 Concrete Reinforcing (031500-1.1B.2), however this Specification Section is not provided. Also Section 031500-3.1A indicates to install concrete accessories and related materials as specified in Section 031100 – Concrete Formwork and this specification is also not provided. Please provide both missing specifications.

RESPONSE TO CLARIFICATION, SUBMITTED AS PART OF AN ADDENDUM:

Specification Sections 031100 and 032000 are not included in this package, as the information for reinforcing and formwork is included in Section 033000.

Forthcoming Addendum 2 will correct the incorrect spec section references noted above.

RESPONSE PROVIDED BY:	Stacy Kwok/ HGA	DATE:	8/31/17
-----------------------	-----------------	-------	---------

Attach additional numbered sheets as necessary; however, only one (1) request shall be contained on each submitted form.

Attachment 4

**PRE-BID CLARIFICATION ("PBC") FORM
(ALL questions to be submitted on this form ONLY)**

PBC # **24**
(RSCCD USE ONLY):

PROJECT NAME:	RFP #1718-173 Science Center at Santa Ana College		
PROJECT NUMBER:	3049	DSA NUMBER:	04-115788
TO:	Allison Coburn	EMAIL:	Coburn_Allison@rsccd.edu

DATE:	August 7th, 2017		
FROM:	Luis Giordano McCarthy Building Companies	EMAIL:	lgiordano@mccarthy.com

SPECIFICATION NUMBER:	032000; 031500; 031100	DRAWING NUMBER:	
-----------------------	------------------------	-----------------	--

REQUESTED CLARIFICATION:

Specification Section 031500 – Concrete Accessories references Related Section 032000 Concrete Reinforcing (031500-1.1B.2), however this Specification Section is not provided. Also Section 031500-3.1A indicates to install concrete accessories and related materials as specified in Section 031100 – Concrete Formwork and this specification is also not provided. Please provide both missing specifications.

RESPONSE TO CLARIFICATION, SUBMITTED AS PART OF AN ADDENDUM:

Specification Sections 031100 and 032000 are not included in this package, as the information for reinforcing and formwork is included in Section 033000.

Forthcoming Addendum 2 will correct the incorrect spec section references noted above.

RESPONSE PROVIDED BY:	Stacy Kwok/ HGA	DATE:	8/31/17
-----------------------	-----------------	-------	---------

Attach additional numbered sheets as necessary; however, only one (1) request shall be contained on each submitted form.

Attachment 4

**PRE-BID CLARIFICATION ("PBC") FORM
(ALL questions to be submitted on this form ONLY)**

PBC # **25**
(RSCCD USE ONLY):

PROJECT NAME:	RFP #1718-173 Science Center at Santa Ana College		
PROJECT NUMBER:	3049	DSA NUMBER:	04-115788
TO:	Allison Coburn	EMAIL:	Coburn_Allison@rsccd.edu

DATE:	August 7th, 2017		
FROM:	Luis Giordano McCarthy Building Companies	EMAIL:	lgiordano@mccarthy.com

SPECIFICATION NUMBER:	032000; 031500; 031100	DRAWING NUMBER:	
-----------------------	------------------------	-----------------	--

REQUESTED CLARIFICATION:

Specification Section 031500 – Concrete Accessories references Related Section 032000 Concrete Reinforcing (031500-1.1B.2), however this Specification Section is not provided. Also Section 031500-3.1A indicates to install concrete accessories and related materials as specified in Section 031100 – Concrete Formwork and this specification is also not provided. Please provide both missing specifications.

RESPONSE TO CLARIFICATION, SUBMITTED AS PART OF AN ADDENDUM:

Specification Sections 031100 and 032000 are not included in this package, as the information for reinforcing and formwork is included in Section 033000.

Forthcoming Addendum 2 will correct the incorrect spec section references noted above.

RESPONSE PROVIDED BY:	Stacy Kwok/ HGA	DATE:	8/31/17
-----------------------	-----------------	-------	---------

Attach additional numbered sheets as necessary; however, only one (1) request shall be contained on each submitted form.

Attachment 4

**PRE-BID CLARIFICATION ("PBC") FORM
(ALL questions to be submitted on this form ONLY)**

PBC # **26**
(RSCCD USE ONLY):

PROJECT NAME:	RFP #1718-173 Science Center at Santa Ana College		
PROJECT NUMBER:	3049	DSA NUMBER:	04-115788
TO:	Allison Coburn	EMAIL:	Coburn_Allison@rsccd.edu

DATE:	August 7th, 2017		
FROM:	Luis Giordano McCarthy Building Companies	EMAIL:	lgiordano@mccarthy.com

SPECIFICATION NUMBER:	032000; 031500; 031100	DRAWING NUMBER:	
-----------------------	------------------------	-----------------	--

REQUESTED CLARIFICATION:

Specification Section 031500 – Concrete Accessories references Related Section 032000 Concrete Reinforcing (031500-1.1B.2), however this Specification Section is not provided. Also Section 031500-3.1A indicates to install concrete accessories and related materials as specified in Section 031100 – Concrete Formwork and this specification is also not provided. Please provide both missing specifications.

RESPONSE TO CLARIFICATION, SUBMITTED AS PART OF AN ADDENDUM:

Specification Sections 031100 and 032000 are not included in this package, as the information for reinforcing and formwork is included in Section 033000.

Forthcoming Addendum 2 will correct the incorrect spec section references noted above.

RESPONSE PROVIDED BY:	Stacy Kwok/ HGA	DATE:	8/31/17
-----------------------	-----------------	-------	---------

Attach additional numbered sheets as necessary; however, only one (1) request shall be contained on each submitted form.

Attachment 4

**PRE-BID CLARIFICATION ("PBC") FORM
(ALL questions to be submitted on this form ONLY)**

PBC # **27**
(RSCCD USE ONLY):

PROJECT NAME:	RFP #1718-173 Science Center at Santa Ana College		
PROJECT NUMBER:	3049	DSA NUMBER:	04-115788
TO:	Allison Coburn	EMAIL:	Coburn_Allison@rsccd.edu

DATE:	August 7th, 2017		
FROM:	Luis Giordano McCarthy Building Companies	EMAIL:	lgiordano@mccarthy.com

SPECIFICATION NUMBER:	032000; 031500; 031100	DRAWING NUMBER:	
-----------------------	------------------------	-----------------	--

REQUESTED CLARIFICATION:

Specification Section 031500 – Concrete Accessories references Related Section 032000 Concrete Reinforcing (031500-1.1B.2), however this Specification Section is not provided. Also Section 031500-3.1A indicates to install concrete accessories and related materials as specified in Section 031100 – Concrete Formwork and this specification is also not provided. Please provide both missing specifications.

RESPONSE TO CLARIFICATION, SUBMITTED AS PART OF AN ADDENDUM:

Specification Sections 031100 and 032000 are not included in this package, as the information for reinforcing and formwork is included in Section 033000.

Forthcoming Addendum 2 will correct the incorrect spec section references noted above.

RESPONSE PROVIDED BY:	Stacy Kwok/ HGA	DATE:	8/31/17
-----------------------	-----------------	-------	---------

Attach additional numbered sheets as necessary; however, only one (1) request shall be contained on each submitted form.

Attachment 4

**PRE-BID CLARIFICATION ("PBC") FORM
(ALL questions to be submitted on this form ONLY)**

PBC # **28**
(RSCCD USE ONLY):

PROJECT NAME:	RFP #1718-173 Science Center at Santa Ana College		
PROJECT NUMBER:	3049	DSA NUMBER:	04-115788
TO:	Allison Coburn	EMAIL:	Coburn_Allison@rsccd.edu

DATE:	August 7th, 2017		
FROM:	Luis Giordano McCarthy Building Companies	EMAIL:	lgiordano@mccarthy.com

SPECIFICATION NUMBER:	032000; 031500; 031100	DRAWING NUMBER:	
-----------------------	------------------------	-----------------	--

REQUESTED CLARIFICATION:

Specification Section 031500 – Concrete Accessories references Related Section 032000 Concrete Reinforcing (031500-1.1B.2), however this Specification Section is not provided. Also Section 031500-3.1A indicates to install concrete accessories and related materials as specified in Section 031100 – Concrete Formwork and this specification is also not provided. Please provide both missing specifications.

RESPONSE TO CLARIFICATION, **SUBMITTED AS PART OF AN ADDENDUM:**

Specification Sections 031100 and 032000 are not included in this package, as the information for reinforcing and formwork is included in Section 033000.

Forthcoming Addendum 2 will correct the incorrect spec section references noted above.

RESPONSE PROVIDED BY:	Stacy Kwok/ HGA	DATE:	8/31/17
-----------------------	-----------------	-------	---------

Attach additional numbered sheets as necessary; however, only one (1) request shall be contained on each submitted form.

Attachment 4

**PRE-BID CLARIFICATION ("PBC") FORM
(ALL questions to be submitted on this form ONLY)**

PBC # **29**
(RSCCD USE ONLY):

PROJECT NAME:	RFP #1718-173 Science Center at Santa Ana College		
PROJECT NUMBER:	3049	DSA NUMBER:	04-115788
TO:	Allison Coburn	EMAIL:	Coburn_Allison@rsccd.edu

DATE:	August 7th, 2017		
FROM:	Luis Giordano McCarthy Building Companies	EMAIL:	lgiordano@mccarthy.com

SPECIFICATION NUMBER:	032000; 031500; 031100	DRAWING NUMBER:	
-----------------------	------------------------	-----------------	--

REQUESTED CLARIFICATION:

Specification Section 031500 – Concrete Accessories references Related Section 032000 Concrete Reinforcing (031500-1.1B.2), however this Specification Section is not provided. Also Section 031500-3.1A indicates to install concrete accessories and related materials as specified in Section 031100 – Concrete Formwork and this specification is also not provided. Please provide both missing specifications.

RESPONSE TO CLARIFICATION, **SUBMITTED AS PART OF AN ADDENDUM:**

Specification Sections 031100 and 032000 are not included in this package, as the information for reinforcing and formwork is included in Section 033000.

Forthcoming Addendum 2 will correct the incorrect spec section references noted above.

RESPONSE PROVIDED BY:	Stacy Kwok/ HGA	DATE:	8/31/17
-----------------------	-----------------	-------	---------

Attach additional numbered sheets as necessary; however, only one (1) request shall be contained on each submitted form.

Attachment 4

**PRE-BID CLARIFICATION ("PBC") FORM
(ALL questions to be submitted on this form ONLY)**

PBC # **30**
(RSCCD USE ONLY):

PROJECT NAME:	RFP #1718-173 Science Center at Santa Ana College		
PROJECT NUMBER:	3049	DSA NUMBER:	04-115788
TO:	Allison Coburn	EMAIL:	Coburn_Allison@rsccd.edu

DATE:	August 7th, 2017		
FROM:	Luis Giordano McCarthy Building Companies	EMAIL:	lgiordano@mccarthy.com

SPECIFICATION NUMBER:	032000; 031500; 031100	DRAWING NUMBER:	
-----------------------	------------------------	-----------------	--

REQUESTED CLARIFICATION:

Specification Section 031500 – Concrete Accessories references Related Section 032000 Concrete Reinforcing (031500-1.1B.2), however this Specification Section is not provided. Also Section 031500-3.1A indicates to install concrete accessories and related materials as specified in Section 031100 – Concrete Formwork and this specification is also not provided. Please provide both missing specifications.

RESPONSE TO CLARIFICATION, SUBMITTED AS PART OF AN ADDENDUM:

Specification Sections 031100 and 032000 are not included in this package, as the information for reinforcing and formwork is included in Section 033000.

Forthcoming Addendum 2 will correct the incorrect spec section references noted above.

RESPONSE PROVIDED BY:	Stacy Kwok/ HGA	DATE:	8/31/17
-----------------------	-----------------	-------	---------

Attach additional numbered sheets as necessary; however, only one (1) request shall be contained on each submitted form.

Attachment 4

**PRE-BID CLARIFICATION ("PBC") FORM
(ALL questions to be submitted on this form ONLY)**

PBC # **31**
(RSCCD USE ONLY):

PROJECT NAME:	RFP #1718-173 Science Center at Santa Ana College		
PROJECT NUMBER:	3049	DSA NUMBER:	04-115788
TO:	Allison Coburn	EMAIL:	Coburn_Allison@rsccd.edu

DATE:	August 7th, 2017		
FROM:	Luis Giordano McCarthy Building Companies	EMAIL:	lgiordano@mccarthy.com

SPECIFICATION NUMBER:	032000; 031500; 031100	DRAWING NUMBER:	
-----------------------	------------------------	-----------------	--

REQUESTED CLARIFICATION:

Specification Section 031500 – Concrete Accessories references Related Section 032000 Concrete Reinforcing (031500-1.1B.2), however this Specification Section is not provided. Also Section 031500-3.1A indicates to install concrete accessories and related materials as specified in Section 031100 – Concrete Formwork and this specification is also not provided. Please provide both missing specifications.

RESPONSE TO CLARIFICATION, SUBMITTED AS PART OF AN ADDENDUM:

Specification Sections 031100 and 032000 are not included in this package, as the information for reinforcing and formwork is included in Section 033000.

Forthcoming Addendum 2 will correct the incorrect spec section references noted above.

RESPONSE PROVIDED BY:	Stacy Kwok/ HGA	DATE:	8/31/17
-----------------------	-----------------	-------	---------

Attach additional numbered sheets as necessary; however, only one (1) request shall be contained on each submitted form.

Attachment 4

**PRE-BID CLARIFICATION ("PBC") FORM
(ALL questions to be submitted on this form ONLY)**

PBC # **32**
(RSCCD USE ONLY):

PROJECT NAME:	RFP #1718-173 Science Center at Santa Ana College		
PROJECT NUMBER:	3049	DSA NUMBER:	04-115788
TO:	Allison Coburn	EMAIL:	Coburn_Allison@rsccd.edu

DATE:	August 7th, 2017		
FROM:	Luis Giordano McCarthy Building Companies	EMAIL:	lgiordano@mccarthy.com

SPECIFICATION NUMBER:	032000; 031500; 031100	DRAWING NUMBER:	
-----------------------	------------------------	-----------------	--

REQUESTED CLARIFICATION:

Specification Section 031500 – Concrete Accessories references Related Section 032000 Concrete Reinforcing (031500-1.1B.2), however this Specification Section is not provided. Also Section 031500-3.1A indicates to install concrete accessories and related materials as specified in Section 031100 – Concrete Formwork and this specification is also not provided. Please provide both missing specifications.

RESPONSE TO CLARIFICATION, SUBMITTED AS PART OF AN ADDENDUM:

Specification Sections 031100 and 032000 are not included in this package, as the information for reinforcing and formwork is included in Section 033000.

Forthcoming Addendum 2 will correct the incorrect spec section references noted above.

RESPONSE PROVIDED BY:	Stacy Kwok/ HGA	DATE:	8/31/17
-----------------------	-----------------	-------	---------

Attach additional numbered sheets as necessary; however, only one (1) request shall be contained on each submitted form.

Attachment 4

**PRE-BID CLARIFICATION ("PBC") FORM
(ALL questions to be submitted on this form ONLY)**

PBC # **33**
(RSCCD USE ONLY):

PROJECT NAME:	RFP #1718-173 Science Center at Santa Ana College		
PROJECT NUMBER:	3049	DSA NUMBER:	04-115788
TO:	Allison Coburn	EMAIL:	Coburn_Allison@rsccd.edu

DATE:	August 7th, 2017		
FROM:	Luis Giordano McCarthy Building Companies	EMAIL:	lgiordano@mccarthy.com

SPECIFICATION NUMBER:	032000; 031500; 031100	DRAWING NUMBER:	
-----------------------	------------------------	-----------------	--

REQUESTED CLARIFICATION:

Specification Section 031500 – Concrete Accessories references Related Section 032000 Concrete Reinforcing (031500-1.1B.2), however this Specification Section is not provided. Also Section 031500-3.1A indicates to install concrete accessories and related materials as specified in Section 031100 – Concrete Formwork and this specification is also not provided. Please provide both missing specifications.

RESPONSE TO CLARIFICATION, SUBMITTED AS PART OF AN ADDENDUM:

Specification Sections 031100 and 032000 are not included in this package, as the information for reinforcing and formwork is included in Section 033000.

Forthcoming Addendum 2 will correct the incorrect spec section references noted above.

RESPONSE PROVIDED BY:	Stacy Kwok/ HGA	DATE:	8/31/17
-----------------------	-----------------	-------	---------

Attach additional numbered sheets as necessary; however, only one (1) request shall be contained on each submitted form.

Attachment 4

**PRE-BID CLARIFICATION ("PBC") FORM
(ALL questions to be submitted on this form ONLY)**

PBC # **34**
(RSCCD USE ONLY):

PROJECT NAME:	RFP #1718-173 Science Center at Santa Ana College		
PROJECT NUMBER:	3049	DSA NUMBER:	04-115788
TO:	Allison Coburn	EMAIL:	Coburn_Allison@rsccd.edu

DATE:	August 7th, 2017		
FROM:	Luis Giordano McCarthy Building Companies	EMAIL:	lgiordano@mccarthy.com

SPECIFICATION NUMBER:	032000; 031500; 031100	DRAWING NUMBER:	
-----------------------	------------------------	-----------------	--

REQUESTED CLARIFICATION:

Specification Section 031500 – Concrete Accessories references Related Section 032000 Concrete Reinforcing (031500-1.1B.2), however this Specification Section is not provided. Also Section 031500-3.1A indicates to install concrete accessories and related materials as specified in Section 031100 – Concrete Formwork and this specification is also not provided. Please provide both missing specifications.

RESPONSE TO CLARIFICATION, SUBMITTED AS PART OF AN ADDENDUM:

Specification Sections 031100 and 032000 are not included in this package, as the information for reinforcing and formwork is included in Section 033000.

Forthcoming Addendum 2 will correct the incorrect spec section references noted above.

RESPONSE PROVIDED BY:	Stacy Kwok/ HGA	DATE:	8/31/17
-----------------------	-----------------	-------	---------

Attach additional numbered sheets as necessary; however, only one (1) request shall be contained on each submitted form.

Attachment 4

**PRE-BID CLARIFICATION ("PBC") FORM
(ALL questions to be submitted on this form ONLY)**

PBC # **35**
(RSCCD USE ONLY):

PROJECT NAME:	RFP #1718-173 Science Center at Santa Ana College		
PROJECT NUMBER:	3049	DSA NUMBER:	04-115788
TO:	Allison Coburn	EMAIL:	Coburn_Allison@rsccd.edu

DATE:	August 7th, 2017		
FROM:	Luis Giordano McCarthy Building Companies	EMAIL:	lgiordano@mccarthy.com

SPECIFICATION NUMBER:	032000; 031500; 031100	DRAWING NUMBER:	
-----------------------	------------------------	-----------------	--

REQUESTED CLARIFICATION:

Specification Section 031500 – Concrete Accessories references Related Section 032000 Concrete Reinforcing (031500-1.1B.2), however this Specification Section is not provided. Also Section 031500-3.1A indicates to install concrete accessories and related materials as specified in Section 031100 – Concrete Formwork and this specification is also not provided. Please provide both missing specifications.

RESPONSE TO CLARIFICATION, SUBMITTED AS PART OF AN ADDENDUM:

Specification Sections 031100 and 032000 are not included in this package, as the information for reinforcing and formwork is included in Section 033000.

Forthcoming Addendum 2 will correct the incorrect spec section references noted above.

RESPONSE PROVIDED BY:	Stacy Kwok/ HGA	DATE:	8/31/17
-----------------------	-----------------	-------	---------

Attach additional numbered sheets as necessary; however, only one (1) request shall be contained on each submitted form.

Attachment 4

**PRE-BID CLARIFICATION ("PBC") FORM
(ALL questions to be submitted on this form ONLY)**

PBC # **36**
(RSCCD USE ONLY):

PROJECT NAME:	RFP #1718-173 Science Center at Santa Ana College		
PROJECT NUMBER:	3049	DSA NUMBER:	04-115788
TO:	Allison Coburn	EMAIL:	Coburn_Allison@rsccd.edu

DATE:	August 7th, 2017		
FROM:	Luis Giordano McCarthy Building Companies	EMAIL:	lgiordano@mccarthy.com

SPECIFICATION NUMBER:	032000; 031500; 031100	DRAWING NUMBER:	
-----------------------	------------------------	-----------------	--

REQUESTED CLARIFICATION:

Specification Section 031500 – Concrete Accessories references Related Section 032000 Concrete Reinforcing (031500-1.1B.2), however this Specification Section is not provided. Also Section 031500-3.1A indicates to install concrete accessories and related materials as specified in Section 031100 – Concrete Formwork and this specification is also not provided. Please provide both missing specifications.

RESPONSE TO CLARIFICATION, SUBMITTED AS PART OF AN ADDENDUM:

Specification Sections 031100 and 032000 are not included in this package, as the information for reinforcing and formwork is included in Section 033000.

Forthcoming Addendum 2 will correct the incorrect spec section references noted above.

RESPONSE PROVIDED BY:	Stacy Kwok/ HGA	DATE:	8/31/17
-----------------------	-----------------	-------	---------

Attach additional numbered sheets as necessary; however, only one (1) request shall be contained on each submitted form.

Attachment 4

**PRE-BID CLARIFICATION ("PBC") FORM
(ALL questions to be submitted on this form ONLY)**

PBC # **37**
(RSCCD USE ONLY):

PROJECT NAME:	RFP #1718-173 Science Center at Santa Ana College		
PROJECT NUMBER:	3049	DSA NUMBER:	04-115788
TO:	Allison Coburn	EMAIL:	Coburn_Allison@rsccd.edu

DATE:	August 7th, 2017		
FROM:	Luis Giordano McCarthy Building Companies	EMAIL:	lgiordano@mccarthy.com

SPECIFICATION NUMBER:	032000; 031500; 031100	DRAWING NUMBER:	
-----------------------	------------------------	-----------------	--

REQUESTED CLARIFICATION:

Specification Section 031500 – Concrete Accessories references Related Section 032000 Concrete Reinforcing (031500-1.1B.2), however this Specification Section is not provided. Also Section 031500-3.1A indicates to install concrete accessories and related materials as specified in Section 031100 – Concrete Formwork and this specification is also not provided. Please provide both missing specifications.

RESPONSE TO CLARIFICATION, SUBMITTED AS PART OF AN ADDENDUM:

Specification Sections 031100 and 032000 are not included in this package, as the information for reinforcing and formwork is included in Section 033000.

Forthcoming Addendum 2 will correct the incorrect spec section references noted above.

RESPONSE PROVIDED BY:	Stacy Kwok/ HGA	DATE:	8/31/17
-----------------------	-----------------	-------	---------

Attach additional numbered sheets as necessary; however, only one (1) request shall be contained on each submitted form.

Attachment 4

**PRE-BID CLARIFICATION ("PBC") FORM
(ALL questions to be submitted on this form ONLY)**

PBC # **38**
(RSCCD USE ONLY):

PROJECT NAME:	RFP #1718-173 Science Center at Santa Ana College		
PROJECT NUMBER:	3049	DSA NUMBER:	04-115788
TO:	Allison Coburn	EMAIL:	Coburn_Allison@rsccd.edu

DATE:	August 7th, 2017		
FROM:	Luis Giordano McCarthy Building Companies	EMAIL:	lgiordano@mccarthy.com

SPECIFICATION NUMBER:	032000; 031500; 031100	DRAWING NUMBER:	
-----------------------	------------------------	-----------------	--

REQUESTED CLARIFICATION:

Specification Section 031500 – Concrete Accessories references Related Section 032000 Concrete Reinforcing (031500-1.1B.2), however this Specification Section is not provided. Also Section 031500-3.1A indicates to install concrete accessories and related materials as specified in Section 031100 – Concrete Formwork and this specification is also not provided. Please provide both missing specifications.

RESPONSE TO CLARIFICATION, **SUBMITTED AS PART OF AN ADDENDUM:**

Specification Sections 031100 and 032000 are not included in this package, as the information for reinforcing and formwork is included in Section 033000.

Forthcoming Addendum 2 will correct the incorrect spec section references noted above.

RESPONSE PROVIDED BY:	Stacy Kwok/ HGA	DATE:	8/31/17
-----------------------	-----------------	-------	---------

Attach additional numbered sheets as necessary; however, only one (1) request shall be contained on each submitted form.

Attachment 4

**PRE-BID CLARIFICATION ("PBC") FORM
(ALL questions to be submitted on this form ONLY)**

PBC # **39**
(RSCCD USE ONLY):

PROJECT NAME:	RFP #1718-173 Science Center at Santa Ana College		
PROJECT NUMBER:	3049	DSA NUMBER:	04-115788
TO:	Allison Coburn	EMAIL:	Coburn_Allison@rsccd.edu

DATE:	August 7th, 2017		
FROM:	Luis Giordano McCarthy Building Companies	EMAIL:	lgiordano@mccarthy.com

SPECIFICATION NUMBER:	032000; 031500; 031100	DRAWING NUMBER:	
-----------------------	------------------------	-----------------	--

REQUESTED CLARIFICATION:

Specification Section 031500 – Concrete Accessories references Related Section 032000 Concrete Reinforcing (031500-1.1B.2), however this Specification Section is not provided. Also Section 031500-3.1A indicates to install concrete accessories and related materials as specified in Section 031100 – Concrete Formwork and this specification is also not provided. Please provide both missing specifications.

RESPONSE TO CLARIFICATION, SUBMITTED AS PART OF AN ADDENDUM:

Specification Sections 031100 and 032000 are not included in this package, as the information for reinforcing and formwork is included in Section 033000.

Forthcoming Addendum 2 will correct the incorrect spec section references noted above.

RESPONSE PROVIDED BY:	Stacy Kwok/ HGA	DATE:	8/31/17
-----------------------	-----------------	-------	---------

Attach additional numbered sheets as necessary; however, only one (1) request shall be contained on each submitted form.

Attachment 4

**PRE-BID CLARIFICATION ("PBC") FORM
(ALL questions to be submitted on this form ONLY)**

PBC # **40**
(RSCCD USE ONLY):

PROJECT NAME:	RFP #1718-173 Science Center at Santa Ana College		
PROJECT NUMBER:	3049	DSA NUMBER:	04-115788
TO:	Allison Coburn	EMAIL:	Coburn_Allison@rsccd.edu

DATE:	August 7th, 2017		
FROM:	Luis Giordano McCarthy Building Companies	EMAIL:	lgiordano@mccarthy.com

SPECIFICATION NUMBER:	032000; 031500; 031100	DRAWING NUMBER:	
-----------------------	------------------------	-----------------	--

REQUESTED CLARIFICATION:

Specification Section 031500 – Concrete Accessories references Related Section 032000 Concrete Reinforcing (031500-1.1B.2), however this Specification Section is not provided. Also Section 031500-3.1A indicates to install concrete accessories and related materials as specified in Section 031100 – Concrete Formwork and this specification is also not provided. Please provide both missing specifications.

RESPONSE TO CLARIFICATION, SUBMITTED AS PART OF AN ADDENDUM:

Specification Sections 031100 and 032000 are not included in this package, as the information for reinforcing and formwork is included in Section 033000.

Forthcoming Addendum 2 will correct the incorrect spec section references noted above.

RESPONSE PROVIDED BY:	Stacy Kwok/ HGA	DATE:	8/31/17
-----------------------	-----------------	-------	---------

Attach additional numbered sheets as necessary; however, only one (1) request shall be contained on each submitted form.

Attachment 4

**PRE-BID CLARIFICATION ("PBC") FORM
(ALL questions to be submitted on this form ONLY)**

PBC # **41**
(RSCCD USE ONLY):

PROJECT NAME:	RFP #1718-173 Science Center at Santa Ana College		
PROJECT NUMBER:	3049	DSA NUMBER:	04-115788
TO:	Allison Coburn	EMAIL:	Coburn_Allison@rsccd.edu

DATE:	August 7th, 2017		
FROM:	Luis Giordano McCarthy Building Companies	EMAIL:	lgiordano@mccarthy.com

SPECIFICATION NUMBER:	032000; 031500; 031100	DRAWING NUMBER:	
-----------------------	------------------------	-----------------	--

REQUESTED CLARIFICATION:

Specification Section 031500 – Concrete Accessories references Related Section 032000 Concrete Reinforcing (031500-1.1B.2), however this Specification Section is not provided. Also Section 031500-3.1A indicates to install concrete accessories and related materials as specified in Section 031100 – Concrete Formwork and this specification is also not provided. Please provide both missing specifications.

RESPONSE TO CLARIFICATION, **SUBMITTED AS PART OF AN ADDENDUM:**

Specification Sections 031100 and 032000 are not included in this package, as the information for reinforcing and formwork is included in Section 033000.

Forthcoming Addendum 2 will correct the incorrect spec section references noted above.

RESPONSE PROVIDED BY:	Stacy Kwok/ HGA	DATE:	8/31/17
-----------------------	-----------------	-------	---------

Attach additional numbered sheets as necessary; however, only one (1) request shall be contained on each submitted form.

Attachment 4

**PRE-BID CLARIFICATION ("PBC") FORM
(ALL questions to be submitted on this form ONLY)**

PBC # **42**
(RSCCD USE ONLY):

PROJECT NAME:	RFP #1718-173 Science Center at Santa Ana College		
PROJECT NUMBER:	3049	DSA NUMBER:	04-115788
TO:	Allison Coburn	EMAIL:	Coburn_Allison@rsccd.edu

DATE:	August 7th, 2017		
FROM:	Luis Giordano McCarthy Building Companies	EMAIL:	lgiordano@mccarthy.com

SPECIFICATION NUMBER:	032000; 031500; 031100	DRAWING NUMBER:	
-----------------------	------------------------	-----------------	--

REQUESTED CLARIFICATION:

Specification Section 031500 – Concrete Accessories references Related Section 032000 Concrete Reinforcing (031500-1.1B.2), however this Specification Section is not provided. Also Section 031500-3.1A indicates to install concrete accessories and related materials as specified in Section 031100 – Concrete Formwork and this specification is also not provided. Please provide both missing specifications.

RESPONSE TO CLARIFICATION, SUBMITTED AS PART OF AN ADDENDUM:

Specification Sections 031100 and 032000 are not included in this package, as the information for reinforcing and formwork is included in Section 033000.

Forthcoming Addendum 2 will correct the incorrect spec section references noted above.

RESPONSE PROVIDED BY:	Stacy Kwok/ HGA	DATE:	8/31/17
-----------------------	-----------------	-------	---------

Attach additional numbered sheets as necessary; however, only one (1) request shall be contained on each submitted form.

Attachment 4

**PRE-BID CLARIFICATION ("PBC") FORM
(ALL questions to be submitted on this form ONLY)**

PBC # **43**
(RSCCD USE ONLY):

PROJECT NAME:	RFP #1718-173 Science Center at Santa Ana College		
PROJECT NUMBER:	3049	DSA NUMBER:	04-115788
TO:	Allison Coburn	EMAIL:	Coburn_Allison@rsccd.edu

DATE:	August 7th, 2017		
FROM:	Luis Giordano McCarthy Building Companies	EMAIL:	lgiordano@mccarthy.com

SPECIFICATION NUMBER:	032000; 031500; 031100	DRAWING NUMBER:	
-----------------------	------------------------	-----------------	--

REQUESTED CLARIFICATION:

Specification Section 031500 – Concrete Accessories references Related Section 032000 Concrete Reinforcing (031500-1.1B.2), however this Specification Section is not provided. Also Section 031500-3.1A indicates to install concrete accessories and related materials as specified in Section 031100 – Concrete Formwork and this specification is also not provided. Please provide both missing specifications.

RESPONSE TO CLARIFICATION, SUBMITTED AS PART OF AN ADDENDUM:

Specification Sections 031100 and 032000 are not included in this package, as the information for reinforcing and formwork is included in Section 033000.

Forthcoming Addendum 2 will correct the incorrect spec section references noted above.

RESPONSE PROVIDED BY:	Stacy Kwok/ HGA	DATE:	8/31/17
-----------------------	-----------------	-------	---------

Attach additional numbered sheets as necessary; however, only one (1) request shall be contained on each submitted form.

Attachment 4

**PRE-BID CLARIFICATION ("PBC") FORM
(ALL questions to be submitted on this form ONLY)**

PBC # **45**
(RSCCD USE ONLY):

PROJECT NAME:	RFP #1718-173 Science Center at Santa Ana College		
PROJECT NUMBER:	3049	DSA NUMBER:	04-115788
TO:	Allison Coburn	EMAIL:	Coburn_Allison@rsccd.edu

DATE:	August 7th, 2017		
FROM:	Luis Giordano McCarthy Building Companies	EMAIL:	lgiordano@mccarthy.com

SPECIFICATION NUMBER:	032000; 031500; 031100	DRAWING NUMBER:	
-----------------------	------------------------	-----------------	--

REQUESTED CLARIFICATION:

Specification Section 031500 – Concrete Accessories references Related Section 032000 Concrete Reinforcing (031500-1.1B.2), however this Specification Section is not provided. Also Section 031500-3.1A indicates to install concrete accessories and related materials as specified in Section 031100 – Concrete Formwork and this specification is also not provided. Please provide both missing specifications.

RESPONSE TO CLARIFICATION, SUBMITTED AS PART OF AN ADDENDUM:

Specification Sections 031100 and 032000 are not included in this package, as the information for reinforcing and formwork is included in Section 033000.

Forthcoming Addendum 2 will correct the incorrect spec section references noted above.

RESPONSE PROVIDED BY:	Stacy Kwok/ HGA	DATE:	8/31/17
-----------------------	-----------------	-------	---------

Attach additional numbered sheets as necessary; however, only one (1) request shall be contained on each submitted form.

Attachment 4

**PRE-BID CLARIFICATION ("PBC") FORM
(ALL questions to be submitted on this form ONLY)**

PBC # **46**
(RSCCD USE ONLY):

PROJECT NAME:	RFP #1718-173 Science Center at Santa Ana College		
PROJECT NUMBER:	3049	DSA NUMBER:	04-115788
TO:	Allison Coburn	EMAIL:	Coburn_Allison@rsccd.edu

DATE:	August 7th, 2017		
FROM:	Luis Giordano McCarthy Building Companies	EMAIL:	lgiordano@mccarthy.com

SPECIFICATION NUMBER:	032000; 031500; 031100	DRAWING NUMBER:	
-----------------------	------------------------	-----------------	--

REQUESTED CLARIFICATION:

Specification Section 031500 – Concrete Accessories references Related Section 032000 Concrete Reinforcing (031500-1.1B.2), however this Specification Section is not provided. Also Section 031500-3.1A indicates to install concrete accessories and related materials as specified in Section 031100 – Concrete Formwork and this specification is also not provided. Please provide both missing specifications.

RESPONSE TO CLARIFICATION, SUBMITTED AS PART OF AN ADDENDUM:

Specification Sections 031100 and 032000 are not included in this package, as the information for reinforcing and formwork is included in Section 033000.

Forthcoming Addendum 2 will correct the incorrect spec section references noted above.

RESPONSE PROVIDED BY:	Stacy Kwok/ HGA	DATE:	8/31/17
-----------------------	-----------------	-------	---------

Attach additional numbered sheets as necessary; however, only one (1) request shall be contained on each submitted form.

Attachment 4

**PRE-BID CLARIFICATION ("PBC") FORM
(ALL questions to be submitted on this form ONLY)**

PBC # **47**
(RSCCD USE ONLY):

PROJECT NAME:	RFP #1718-173 Science Center at Santa Ana College		
PROJECT NUMBER:	3049	DSA NUMBER:	04-115788
TO:	Allison Coburn	EMAIL:	Coburn_Allison@rsccd.edu

DATE:	August 7th, 2017		
FROM:	Luis Giordano McCarthy Building Companies	EMAIL:	lgiordano@mccarthy.com

SPECIFICATION NUMBER:	032000; 031500; 031100	DRAWING NUMBER:	
-----------------------	------------------------	-----------------	--

REQUESTED CLARIFICATION:

Specification Section 031500 – Concrete Accessories references Related Section 032000 Concrete Reinforcing (031500-1.1B.2), however this Specification Section is not provided. Also Section 031500-3.1A indicates to install concrete accessories and related materials as specified in Section 031100 – Concrete Formwork and this specification is also not provided. Please provide both missing specifications.

RESPONSE TO CLARIFICATION, SUBMITTED AS PART OF AN ADDENDUM:

Specification Sections 031100 and 032000 are not included in this package, as the information for reinforcing and formwork is included in Section 033000.

Forthcoming Addendum 2 will correct the incorrect spec section references noted above.

RESPONSE PROVIDED BY:	Stacy Kwok/ HGA	DATE:	8/31/17
-----------------------	-----------------	-------	---------

Attach additional numbered sheets as necessary; however, only one (1) request shall be contained on each submitted form.

Attachment 4

**PRE-BID CLARIFICATION ("PBC") FORM
(ALL questions to be submitted on this form ONLY)**

PBC # **48**
(RSCCD USE ONLY):

PROJECT NAME:	RFP #1718-173 Science Center at Santa Ana College		
PROJECT NUMBER:	3049	DSA NUMBER:	04-115788
TO:	Allison Coburn	EMAIL:	Coburn_Allison@rsccd.edu

DATE:	August 7th, 2017		
FROM:	Luis Giordano McCarthy Building Companies	EMAIL:	lgiordano@mccarthy.com

SPECIFICATION NUMBER:	032000; 031500; 031100	DRAWING NUMBER:	
-----------------------	------------------------	-----------------	--

REQUESTED CLARIFICATION:

Specification Section 031500 – Concrete Accessories references Related Section 032000 Concrete Reinforcing (031500-1.1B.2), however this Specification Section is not provided. Also Section 031500-3.1A indicates to install concrete accessories and related materials as specified in Section 031100 – Concrete Formwork and this specification is also not provided. Please provide both missing specifications.

RESPONSE TO CLARIFICATION, SUBMITTED AS PART OF AN ADDENDUM:

Specification Sections 031100 and 032000 are not included in this package, as the information for reinforcing and formwork is included in Section 033000.

Forthcoming Addendum 2 will correct the incorrect spec section references noted above.

RESPONSE PROVIDED BY:	Stacy Kwok/ HGA	DATE:	8/31/17
-----------------------	-----------------	-------	---------

Attach additional numbered sheets as necessary; however, only one (1) request shall be contained on each submitted form.

Attachment 4

**PRE-BID CLARIFICATION ("PBC") FORM
(ALL questions to be submitted on this form ONLY)**

PBC # **49**
(RSCCD USE ONLY):

PROJECT NAME:	RFP #1718-173 Science Center at Santa Ana College		
PROJECT NUMBER:	3049	DSA NUMBER:	04-115788
TO:	Allison Coburn	EMAIL:	Coburn_Allison@rsccd.edu

DATE:	August 7th, 2017		
FROM:	Luis Giordano McCarthy Building Companies	EMAIL:	lgiordano@mccarthy.com

SPECIFICATION NUMBER:	032000; 031500; 031100	DRAWING NUMBER:	
-----------------------	------------------------	-----------------	--

REQUESTED CLARIFICATION:

Specification Section 031500 – Concrete Accessories references Related Section 032000 Concrete Reinforcing (031500-1.1B.2), however this Specification Section is not provided. Also Section 031500-3.1A indicates to install concrete accessories and related materials as specified in Section 031100 – Concrete Formwork and this specification is also not provided. Please provide both missing specifications.

RESPONSE TO CLARIFICATION, SUBMITTED AS PART OF AN ADDENDUM:

Specification Sections 031100 and 032000 are not included in this package, as the information for reinforcing and formwork is included in Section 033000.

Forthcoming Addendum 2 will correct the incorrect spec section references noted above.

RESPONSE PROVIDED BY:	Stacy Kwok/ HGA	DATE:	8/31/17
-----------------------	-----------------	-------	---------

Attach additional numbered sheets as necessary; however, only one (1) request shall be contained on each submitted form.

Attachment 4

**PRE-BID CLARIFICATION ("PBC") FORM
(ALL questions to be submitted on this form ONLY)**

PBC # **51**
(RSCCD USE ONLY):

PROJECT NAME:	RFP #1718-173 Science Center at Santa Ana College		
PROJECT NUMBER:	3049	DSA NUMBER:	04-115788
TO:	Allison Coburn	EMAIL:	Coburn_Allison@rsccd.edu

DATE:	August 7th, 2017		
FROM:	Luis Giordano McCarthy Building Companies	EMAIL:	lgiordano@mccarthy.com

SPECIFICATION NUMBER:	032000; 031500; 031100	DRAWING NUMBER:	
-----------------------	------------------------	-----------------	--

REQUESTED CLARIFICATION:

Specification Section 031500 – Concrete Accessories references Related Section 032000 Concrete Reinforcing (031500-1.1B.2), however this Specification Section is not provided. Also Section 031500-3.1A indicates to install concrete accessories and related materials as specified in Section 031100 – Concrete Formwork and this specification is also not provided. Please provide both missing specifications.

RESPONSE TO CLARIFICATION, SUBMITTED AS PART OF AN ADDENDUM:

Specification Sections 031100 and 032000 are not included in this package, as the information for reinforcing and formwork is included in Section 033000.

Forthcoming Addendum 2 will correct the incorrect spec section references noted above.

RESPONSE PROVIDED BY:	Stacy Kwok/ HGA	DATE:	8/31/17
-----------------------	-----------------	-------	---------

Attach additional numbered sheets as necessary; however, only one (1) request shall be contained on each submitted form.

Attachment 4

**PRE-BID CLARIFICATION ("PBC") FORM
(ALL questions to be submitted on this form ONLY)**

PBC # **52**
(RSCCD USE ONLY):

PROJECT NAME:	RFP #1718-173 Science Center at Santa Ana College		
PROJECT NUMBER:	3049	DSA NUMBER:	04-115788
TO:	Allison Coburn	EMAIL:	Coburn_Allison@rsccd.edu

DATE:	August 7th, 2017		
FROM:	Luis Giordano McCarthy Building Companies	EMAIL:	lgiordano@mccarthy.com

SPECIFICATION NUMBER:	032000; 031500; 031100	DRAWING NUMBER:	
-----------------------	------------------------	-----------------	--

REQUESTED CLARIFICATION:

Specification Section 031500 – Concrete Accessories references Related Section 032000 Concrete Reinforcing (031500-1.1B.2), however this Specification Section is not provided. Also Section 031500-3.1A indicates to install concrete accessories and related materials as specified in Section 031100 – Concrete Formwork and this specification is also not provided. Please provide both missing specifications.

RESPONSE TO CLARIFICATION, SUBMITTED AS PART OF AN ADDENDUM:

Specification Sections 031100 and 032000 are not included in this package, as the information for reinforcing and formwork is included in Section 033000.

Forthcoming Addendum 2 will correct the incorrect spec section references noted above.

RESPONSE PROVIDED BY:	Stacy Kwok/ HGA	DATE:	8/31/17
-----------------------	-----------------	-------	---------

Attach additional numbered sheets as necessary; however, only one (1) request shall be contained on each submitted form.

Attachment 4

**PRE-BID CLARIFICATION ("PBC") FORM
(ALL questions to be submitted on this form ONLY)**

PBC # **53**
(RSCCD USE ONLY):

PROJECT NAME:	RFP #1718-173 Science Center at Santa Ana College		
PROJECT NUMBER:	3049	DSA NUMBER:	04-115788
TO:	Allison Coburn	EMAIL:	Coburn_Allison@rsccd.edu

DATE:	August 7th, 2017		
FROM:	Luis Giordano McCarthy Building Companies	EMAIL:	lgiordano@mccarthy.com

SPECIFICATION NUMBER:	032000; 031500; 031100	DRAWING NUMBER:	
-----------------------	------------------------	-----------------	--

REQUESTED CLARIFICATION:

Specification Section 031500 – Concrete Accessories references Related Section 032000 Concrete Reinforcing (031500-1.1B.2), however this Specification Section is not provided. Also Section 031500-3.1A indicates to install concrete accessories and related materials as specified in Section 031100 – Concrete Formwork and this specification is also not provided. Please provide both missing specifications.

RESPONSE TO CLARIFICATION, SUBMITTED AS PART OF AN ADDENDUM:

Specification Sections 031100 and 032000 are not included in this package, as the information for reinforcing and formwork is included in Section 033000.

Forthcoming Addendum 2 will correct the incorrect spec section references noted above.

RESPONSE PROVIDED BY:	Stacy Kwok/ HGA	DATE:	8/31/17
-----------------------	-----------------	-------	---------

Attach additional numbered sheets as necessary; however, only one (1) request shall be contained on each submitted form.

Attachment 4

**PRE-BID CLARIFICATION ("PBC") FORM
(ALL questions to be submitted on this form ONLY)**

PBC # **54**
(RSCCD USE ONLY):

PROJECT NAME:	RFP #1718-173 Science Center at Santa Ana College		
PROJECT NUMBER:	3049	DSA NUMBER:	04-115788
TO:	Allison Coburn	EMAIL:	Coburn_Allison@rsccd.edu

DATE:	August 7th, 2017		
FROM:	Luis Giordano McCarthy Building Companies	EMAIL:	lgiordano@mccarthy.com

SPECIFICATION NUMBER:	032000; 031500; 031100	DRAWING NUMBER:	
-----------------------	------------------------	-----------------	--

REQUESTED CLARIFICATION:

Specification Section 031500 – Concrete Accessories references Related Section 032000 Concrete Reinforcing (031500-1.1B.2), however this Specification Section is not provided. Also Section 031500-3.1A indicates to install concrete accessories and related materials as specified in Section 031100 – Concrete Formwork and this specification is also not provided. Please provide both missing specifications.

RESPONSE TO CLARIFICATION, **SUBMITTED AS PART OF AN ADDENDUM:**

Specification Sections 031100 and 032000 are not included in this package, as the information for reinforcing and formwork is included in Section 033000.

Forthcoming Addendum 2 will correct the incorrect spec section references noted above.

RESPONSE PROVIDED BY:	Stacy Kwok/ HGA	DATE:	8/31/17
-----------------------	-----------------	-------	---------

Attach additional numbered sheets as necessary; however, only one (1) request shall be contained on each submitted form.

Attachment 4

**PRE-BID CLARIFICATION ("PBC") FORM
(ALL questions to be submitted on this form ONLY)**

PBC # **55**
(RSCCD USE ONLY):

PROJECT NAME:	RFP #1718-173 Science Center at Santa Ana College		
PROJECT NUMBER:	3049	DSA NUMBER:	04-115788
TO:	Allison Coburn	EMAIL:	Coburn_Allison@rsccd.edu

DATE:	August 7th, 2017		
FROM:	Luis Giordano McCarthy Building Companies	EMAIL:	lgiordano@mccarthy.com

SPECIFICATION NUMBER:	032000; 031500; 031100	DRAWING NUMBER:	
-----------------------	------------------------	-----------------	--

REQUESTED CLARIFICATION:

Specification Section 031500 – Concrete Accessories references Related Section 032000 Concrete Reinforcing (031500-1.1B.2), however this Specification Section is not provided. Also Section 031500-3.1A indicates to install concrete accessories and related materials as specified in Section 031100 – Concrete Formwork and this specification is also not provided. Please provide both missing specifications.

RESPONSE TO CLARIFICATION, **SUBMITTED AS PART OF AN ADDENDUM:**

Specification Sections 031100 and 032000 are not included in this package, as the information for reinforcing and formwork is included in Section 033000.

Forthcoming Addendum 2 will correct the incorrect spec section references noted above.

RESPONSE PROVIDED BY:	Stacy Kwok/ HGA	DATE:	8/31/17
-----------------------	-----------------	-------	---------

Attach additional numbered sheets as necessary; however, only one (1) request shall be contained on each submitted form.

Attachment 4

**PRE-BID CLARIFICATION ("PBC") FORM
(ALL questions to be submitted on this form ONLY)**

PBC # **56**
(RSCCD USE ONLY):

PROJECT NAME:	RFP #1718-173 Science Center at Santa Ana College		
PROJECT NUMBER:	3049	DSA NUMBER:	04-115788
TO:	Allison Coburn	EMAIL:	Coburn_Allison@rsccd.edu

DATE:	August 7th, 2017		
FROM:	Luis Giordano McCarthy Building Companies	EMAIL:	lgiordano@mccarthy.com

SPECIFICATION NUMBER:	032000; 031500; 031100	DRAWING NUMBER:	
-----------------------	------------------------	-----------------	--

REQUESTED CLARIFICATION:

Specification Section 031500 – Concrete Accessories references Related Section 032000 Concrete Reinforcing (031500-1.1B.2), however this Specification Section is not provided. Also Section 031500-3.1A indicates to install concrete accessories and related materials as specified in Section 031100 – Concrete Formwork and this specification is also not provided. Please provide both missing specifications.

RESPONSE TO CLARIFICATION, SUBMITTED AS PART OF AN ADDENDUM:

Specification Sections 031100 and 032000 are not included in this package, as the information for reinforcing and formwork is included in Section 033000.

Forthcoming Addendum 2 will correct the incorrect spec section references noted above.

RESPONSE PROVIDED BY:	Stacy Kwok/ HGA	DATE:	8/31/17
-----------------------	-----------------	-------	---------

Attach additional numbered sheets as necessary; however, only one (1) request shall be contained on each submitted form.

Attachment 4

**PRE-BID CLARIFICATION ("PBC") FORM
(ALL questions to be submitted on this form ONLY)**

PBC # **57**
(RSCCD USE ONLY):

PROJECT NAME:	RFP #1718-173 Science Center at Santa Ana College		
PROJECT NUMBER:	3049	DSA NUMBER:	04-115788
TO:	Allison Coburn	EMAIL:	Coburn_Allison@rsccd.edu

DATE:	August 7th, 2017		
FROM:	Luis Giordano McCarthy Building Companies	EMAIL:	lgiordano@mccarthy.com

SPECIFICATION NUMBER:	032000; 031500; 031100	DRAWING NUMBER:	
-----------------------	------------------------	-----------------	--

REQUESTED CLARIFICATION:

Specification Section 031500 – Concrete Accessories references Related Section 032000 Concrete Reinforcing (031500-1.1B.2), however this Specification Section is not provided. Also Section 031500-3.1A indicates to install concrete accessories and related materials as specified in Section 031100 – Concrete Formwork and this specification is also not provided. Please provide both missing specifications.

RESPONSE TO CLARIFICATION, SUBMITTED AS PART OF AN ADDENDUM:

Specification Sections 031100 and 032000 are not included in this package, as the information for reinforcing and formwork is included in Section 033000.

Forthcoming Addendum 2 will correct the incorrect spec section references noted above.

RESPONSE PROVIDED BY:	Stacy Kwok/ HGA	DATE:	8/31/17
-----------------------	-----------------	-------	---------

Attach additional numbered sheets as necessary; however, only one (1) request shall be contained on each submitted form.

Attachment 4

**PRE-BID CLARIFICATION ("PBC") FORM
(ALL questions to be submitted on this form ONLY)**

PBC # **58**
(RSCCD USE ONLY):

PROJECT NAME:	RFP #1718-173 Science Center at Santa Ana College		
PROJECT NUMBER:	3049	DSA NUMBER:	04-115788
TO:	Allison Coburn	EMAIL:	Coburn_Allison@rsccd.edu

DATE:	August 7th, 2017		
FROM:	Luis Giordano McCarthy Building Companies	EMAIL:	lgiordano@mccarthy.com
SPECIFICATION NUMBER:	032000; 031500; 031100	DRAWING NUMBER:	

REQUESTED CLARIFICATION:

Specification Section 031500 – Concrete Accessories references Related Section 032000 Concrete Reinforcing (031500-1.1B.2), however this Specification Section is not provided. Also Section 031500-3.1A indicates to install concrete accessories and related materials as specified in Section 031100 – Concrete Formwork and this specification is also not provided. Please provide both missing specifications.

RESPONSE TO CLARIFICATION, SUBMITTED AS PART OF AN ADDENDUM:

Specification Sections 031100 and 032000 are not included in this package, as the information for reinforcing and formwork is included in Section 033000.

Concrete Paver

Type: 15"x30" mesa beige

Finish: Shotblast

Pattern: Running Bond

Forthcoming Addendum 2 will correct the incorrect spec section references noted above.

RESPONSE PROVIDED BY:	Stacy Kwok/ HGA	DATE:	8/31/17
-----------------------	-----------------	-------	---------

Attach additional numbered sheets as necessary; however, only one (1) request shall be contained on each submitted form.

Attachment 4

**PRE-BID CLARIFICATION ("PBC") FORM
(ALL questions to be submitted on this form ONLY)**

PBC # **59**
(RSCCD USE ONLY):

PROJECT NAME:	RFP #1718-173 Science Center at Santa Ana College		
PROJECT NUMBER:	3049	DSA NUMBER:	04-115788
TO:	Allison Coburn	EMAIL:	Coburn_Allison@rsccd.edu

DATE:	August 7th, 2017		
FROM:	Luis Giordano McCarthy Building Companies	EMAIL:	lgiordano@mccarthy.com

SPECIFICATION NUMBER:	032000; 031500; 031100	DRAWING NUMBER:	
-----------------------	------------------------	-----------------	--

REQUESTED CLARIFICATION:

Specification Section 031500 – Concrete Accessories references Related Section 032000 Concrete Reinforcing (031500-1.1B.2), however this Specification Section is not provided. Also Section 031500-3.1A indicates to install concrete accessories and related materials as specified in Section 031100 – Concrete Formwork and this specification is also not provided. Please provide both missing specifications.

RESPONSE TO CLARIFICATION, SUBMITTED AS PART OF AN ADDENDUM:

Specification Sections 031100 and 032000 are not included in this package, as the information for reinforcing and formwork is included in Section 033000.

Forthcoming Addendum 2 will correct the incorrect spec section references noted above.

RESPONSE PROVIDED BY:	Stacy Kwok/ HGA	DATE:	8/31/17
-----------------------	-----------------	-------	---------

Attach additional numbered sheets as necessary; however, only one (1) request shall be contained on each submitted form.

Attachment 4

**PRE-BID CLARIFICATION ("PBC") FORM
(ALL questions to be submitted on this form ONLY)**

PBC # **60**
(RSCCD USE ONLY):

PROJECT NAME:	RFP #1718-173 Science Center at Santa Ana College		
PROJECT NUMBER:	3049	DSA NUMBER:	04-115788
TO:	Allison Coburn	EMAIL:	Coburn_Allison@rsccd.edu

DATE:	August 7th, 2017		
FROM:	Luis Giordano McCarthy Building Companies	EMAIL:	lgiordano@mccarthy.com

SPECIFICATION NUMBER:	032000; 031500; 031100	DRAWING NUMBER:	
-----------------------	------------------------	-----------------	--

REQUESTED CLARIFICATION:

Specification Section 031500 – Concrete Accessories references Related Section 032000 Concrete Reinforcing (031500-1.1B.2), however this Specification Section is not provided. Also Section 031500-3.1A indicates to install concrete accessories and related materials as specified in Section 031100 – Concrete Formwork and this specification is also not provided. Please provide both missing specifications.

RESPONSE TO CLARIFICATION, SUBMITTED AS PART OF AN ADDENDUM:

Specification Sections 031100 and 032000 are not included in this package, as the information for reinforcing and formwork is included in Section 033000.

Forthcoming Addendum 2 will correct the incorrect spec section references noted above.

RESPONSE PROVIDED BY:	Stacy Kwok/ HGA	DATE:	8/31/17
-----------------------	-----------------	-------	---------

Attach additional numbered sheets as necessary; however, only one (1) request shall be contained on each submitted form.

Attachment 4

**PRE-BID CLARIFICATION ("PBC") FORM
(ALL questions to be submitted on this form ONLY)**

PBC # **61**
(RSCCD USE ONLY):

PROJECT NAME:	RFP #1718-173 Science Center at Santa Ana College		
PROJECT NUMBER:	3049	DSA NUMBER:	04-115788
TO:	Allison Coburn	EMAIL:	Coburn_Allison@rsccd.edu

DATE:	August 7th, 2017		
FROM:	Luis Giordano McCarthy Building Companies	EMAIL:	lgiordano@mccarthy.com

SPECIFICATION NUMBER:	032000; 031500; 031100	DRAWING NUMBER:	
-----------------------	------------------------	-----------------	--

REQUESTED CLARIFICATION:

Specification Section 031500 – Concrete Accessories references Related Section 032000 Concrete Reinforcing (031500-1.1B.2), however this Specification Section is not provided. Also Section 031500-3.1A indicates to install concrete accessories and related materials as specified in Section 031100 – Concrete Formwork and this specification is also not provided. Please provide both missing specifications.

RESPONSE TO CLARIFICATION, SUBMITTED AS PART OF AN ADDENDUM:

Specification Sections 031100 and 032000 are not included in this package, as the information for reinforcing and formwork is included in Section 033000.

Forthcoming Addendum 2 will correct the incorrect spec section references noted above.

RESPONSE PROVIDED BY:	Stacy Kwok/ HGA	DATE:	8/31/17
-----------------------	-----------------	-------	---------

Attach additional numbered sheets as necessary; however, only one (1) request shall be contained on each submitted form.

Attachment 4

**PRE-BID CLARIFICATION ("PBC") FORM
(ALL questions to be submitted on this form ONLY)**

PBC # **62**
(RSCCD USE ONLY):

PROJECT NAME:	RFP #1718-173 Science Center at Santa Ana College		
PROJECT NUMBER:	3049	DSA NUMBER:	04-115788
TO:	Allison Coburn	EMAIL:	Coburn_Allison@rsccd.edu

DATE:	August 7th, 2017		
FROM:	Luis Giordano McCarthy Building Companies	EMAIL:	lgiordano@mccarthy.com

SPECIFICATION NUMBER:	032000; 031500; 031100	DRAWING NUMBER:	
-----------------------	------------------------	-----------------	--

REQUESTED CLARIFICATION:

Specification Section 031500 – Concrete Accessories references Related Section 032000 Concrete Reinforcing (031500-1.1B.2), however this Specification Section is not provided. Also Section 031500-3.1A indicates to install concrete accessories and related materials as specified in Section 031100 – Concrete Formwork and this specification is also not provided. Please provide both missing specifications.

RESPONSE TO CLARIFICATION, **SUBMITTED AS PART OF AN ADDENDUM:**

Specification Sections 031100 and 032000 are not included in this package, as the information for reinforcing and formwork is included in Section 033000.

Forthcoming Addendum 2 will correct the incorrect spec section references noted above.

RESPONSE PROVIDED BY:	Stacy Kwok/ HGA	DATE:	8/31/17
-----------------------	-----------------	-------	---------

Attach additional numbered sheets as necessary; however, only one (1) request shall be contained on each submitted form.

Attachment 4

**PRE-BID CLARIFICATION ("PBC") FORM
(ALL questions to be submitted on this form ONLY)**

PBC # **63**
(RSCCD USE ONLY):

PROJECT NAME:	RFP #1718-173 Science Center at Santa Ana College		
PROJECT NUMBER:	3049	DSA NUMBER:	04-115788
TO:	Allison Coburn	EMAIL:	Coburn_Allison@rsccd.edu

DATE:	August 7th, 2017		
FROM:	Luis Giordano McCarthy Building Companies	EMAIL:	lgiordano@mccarthy.com

SPECIFICATION NUMBER:	032000; 031500; 031100	DRAWING NUMBER:	
-----------------------	------------------------	-----------------	--

REQUESTED CLARIFICATION:

Specification Section 031500 – Concrete Accessories references Related Section 032000 Concrete Reinforcing (031500-1.1B.2), however this Specification Section is not provided. Also Section 031500-3.1A indicates to install concrete accessories and related materials as specified in Section 031100 – Concrete Formwork and this specification is also not provided. Please provide both missing specifications.

RESPONSE TO CLARIFICATION, SUBMITTED AS PART OF AN ADDENDUM:

Specification Sections 031100 and 032000 are not included in this package, as the information for reinforcing and formwork is included in Section 033000.

Forthcoming Addendum 2 will correct the incorrect spec section references noted above.

RESPONSE PROVIDED BY:	Stacy Kwok/ HGA	DATE:	8/31/17
-----------------------	-----------------	-------	---------

Attach additional numbered sheets as necessary; however, only one (1) request shall be contained on each submitted form.

Attachment 4

**PRE-BID CLARIFICATION ("PBC") FORM
(ALL questions to be submitted on this form ONLY)**

PBC # **64**
(RSCCD USE ONLY):

PROJECT NAME:	RFP #1718-173 Science Center at Santa Ana College		
PROJECT NUMBER:	3049	DSA NUMBER:	04-115788
TO:	Allison Coburn	EMAIL:	Coburn_Allison@rsccd.edu

DATE:	August 7th, 2017		
FROM:	Luis Giordano McCarthy Building Companies	EMAIL:	lgiordano@mccarthy.com

SPECIFICATION NUMBER:	032000; 031500; 031100	DRAWING NUMBER:	
-----------------------	------------------------	-----------------	--

REQUESTED CLARIFICATION:

Specification Section 031500 – Concrete Accessories references Related Section 032000 Concrete Reinforcing (031500-1.1B.2), however this Specification Section is not provided. Also Section 031500-3.1A indicates to install concrete accessories and related materials as specified in Section 031100 – Concrete Formwork and this specification is also not provided. Please provide both missing specifications.

RESPONSE TO CLARIFICATION, SUBMITTED AS PART OF AN ADDENDUM:

Specification Sections 031100 and 032000 are not included in this package, as the information for reinforcing and formwork is included in Section 033000.

Forthcoming Addendum 2 will correct the incorrect spec section references noted above.

RESPONSE PROVIDED BY:	Stacy Kwok/ HGA	DATE:	8/31/17
-----------------------	-----------------	-------	---------

Attach additional numbered sheets as necessary; however, only one (1) request shall be contained on each submitted form.

Attachment 4

**PRE-BID CLARIFICATION ("PBC") FORM
(ALL questions to be submitted on this form ONLY)**

PBC # **65**
(RSCCD USE ONLY):

PROJECT NAME:	RFP #1718-173 Science Center at Santa Ana College		
PROJECT NUMBER:	3049	DSA NUMBER:	04-115788
TO:	Allison Coburn	EMAIL:	Coburn_Allison@rsccd.edu

DATE:	8/22/2017		
FROM:	Max McLellan, ICON Building Supplies	EMAIL:	max@iconbuildingsupplies.com
SPECIFICATION NUMBER:	1718-173	DRAWING NUMBER:	

REQUESTED CLARIFICATION:

Hi, Can you please let me know what the specific DVBE goal i for thi sprojec/ and is it a required spenging goal? or a good faith effort?

RESPONSE TO CLARIFICATION, SUBMITTED AS PART OF AN ADDENDUM:

The DVBE participation percentage is on a project by project basis and a good faith effort. Refer to the form in the RFP on page 8, Attachment 5.

RESPONSE PROVIDED BY:	Allison Coburn	DATE:	8/22/17
-----------------------	----------------	-------	---------

Attach additional numbered sheets as necessary; however, only one (1) request shall be contained on each submitted form.

Attachment 4

**PRE-BID CLARIFICATION ("PBC") FORM
(ALL questions to be submitted on this form ONLY)**

PBC # **66**
(RSCCD USE ONLY):

PROJECT NAME:	RFP #1718-173 Science Center at Santa Ana College		
PROJECT NUMBER:	3049	DSA NUMBER:	04-115788
TO:	Allison Coburn	EMAIL:	Coburn_Allison@rsccd.edu

DATE:	August 7th, 2017		
FROM:	Luis Giordano McCarthy Building Companies	EMAIL:	lgiordano@mccarthy.com

SPECIFICATION NUMBER:	032000; 031500; 031100	DRAWING NUMBER:	
-----------------------	------------------------	-----------------	--

REQUESTED CLARIFICATION:

Specification Section 031500 – Concrete Accessories references Related Section 032000 Concrete Reinforcing (031500-1.1B.2), however this Specification Section is not provided. Also Section 031500-3.1A indicates to install concrete accessories and related materials as specified in Section 031100 – Concrete Formwork and this specification is also not provided. Please provide both missing specifications.

RESPONSE TO CLARIFICATION, SUBMITTED AS PART OF AN ADDENDUM:

Specification Sections 031100 and 032000 are not included in this package, as the information for reinforcing and formwork is included in Section 033000.

Forthcoming Addendum 2 will correct the incorrect spec section references noted above.

RESPONSE PROVIDED BY:	Stacy Kwok/ HGA	DATE:	8/31/17
-----------------------	-----------------	-------	---------

Attach additional numbered sheets as necessary; however, only one (1) request shall be contained on each submitted form.

Attachment 4

**PRE-BID CLARIFICATION ("PBC") FORM
(ALL questions to be submitted on this form ONLY)**

PBC # **67**
(RSCCD USE ONLY):

PROJECT NAME:	RFP #1718-173 Science Center at Santa Ana College		
PROJECT NUMBER:	3049	DSA NUMBER:	04-115788
TO:	Allison Coburn	EMAIL:	Coburn_Allison@rsccd.edu

DATE:	8/25/2017		
FROM:	John Modena, CW Driver	EMAIL:	jmodena@cwdriver.com
SPECIFICATION NUMBER:	074213, 074243	DRAWING NUMBER:	AO11

REQUESTED CLARIFICATION:

SUBJECT: Color Selection for Metal Panel Finishes
Both specification sections stated above, read as shown.
074213-3, paragraph 2.5 Finish, 1. Colors Refer to Material Identification Codes.
074243-2, paragraph 2.5 Finish, B. Colors: Refer to Material Identification Codes

The colors are indicated on drawing A011 Material ID Codes for metal panels MP-1A, MP-1B, MP-1C, but not for MP-2A; this reads "color selected by Architect".
Please provide:

RESPONSE TO CLARIFICATION, SUBMITTED AS PART OF AN ADDENDUM:

MP-2A color to be Weathered Zinc (Mica).

RESPONSE PROVIDED BY:	Stacy Kwok/ HGA	DATE:	8/30/17
-----------------------	-----------------	-------	---------

Attach additional numbered sheets as necessary; however, only one (1) request shall be contained on each submitted form.

Attachment 4

**PRE-BID CLARIFICATION ("PBC") FORM
(ALL questions to be submitted on this form ONLY)**

PBC # **68**
(RSCCD USE ONLY):

PROJECT NAME:	RFP #1718-173 Science Center at Santa Ana College		
PROJECT NUMBER:	3049	DSA NUMBER:	04-115788
TO:	Allison Coburn	EMAIL:	Coburn_Allison@rsccd.edu

DATE:	8/25/2017		
FROM:	John Modena, CW Driver	EMAIL:	jmodena@cwdriver.com
SPECIFICATION NUMBER:	011100	DRAWING NUMBER:	A062, A011

REQUESTED CLARIFICATION:

Sheet A062, note a bottom right says "Greenhouse assembly and glazing provided by Greenhouse Vendor. CMU wall base provided by Contractor". Sheet A011 calls for International Greenhouse as the Manufacturer.

Please clarify if procurement and installation of the Greenhouse assembly and glazing is part of the General Contractor scope or whether it is contracted direct by the District, therefore NIC. If it is part of the General Contractor scope, please provide Manufacturer rep contact info, model number, spec sheets and product details.

RESPONSE TO CLARIFICATION, SUBMITTED AS PART OF AN ADDENDUM:

Procurement and installation of the Greenhouse assembly to be provided by General contractor.


Please contact: Jeff Bridgewater (jeff.bridgewater@igcusa.com) and Ben George (ben.george@igcusa.com) from International Greenhouse as basis of design. Model number is TR2040DG.

Refer to non-DSA approved basis of design Greenhouse details on the following page for reference.


RESPONSE PROVIDED BY:	Stacy Kwok/ HGA	DATE:	8/30/17
-----------------------	-----------------	-------	---------

Attach additional numbered sheets as necessary; however, only one (1) request shall be contained on each submitted form.


GREENHOUSE IS DEFERRED APPROVAL AND WILL REQUIRE FULLY ENGINEERED SUBMITTAL PACKAGE. DETAILS ON THIS SHEET ARE PROVIDED FOR BASIS OF DESIGN.

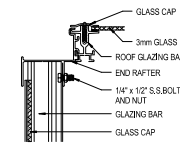


9 END RAFTER DETAIL
6" x 1'-0"

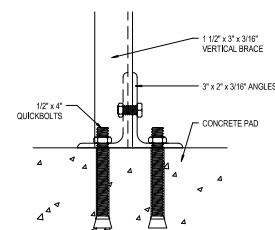


5 VERTICAL BRACE ANCHORING
6" x 1'-0"

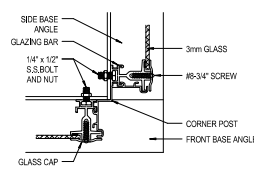


8 CORNER POST DETAIL
6" x 1'-0"

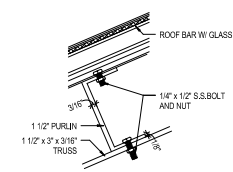


4 PURLIN SECTION
6" x 1'-0"

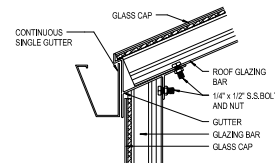


12 GUTTER DETAIL
6" x 1'-0"

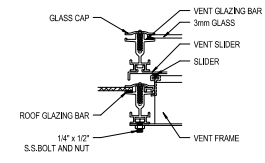


7 VENT AND ROOF BAR DETAIL
6" x 1'-0"

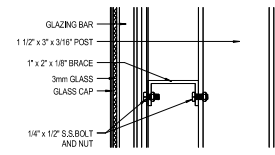


3 BRACE CONNECTION DETAIL
6" x 1'-0"

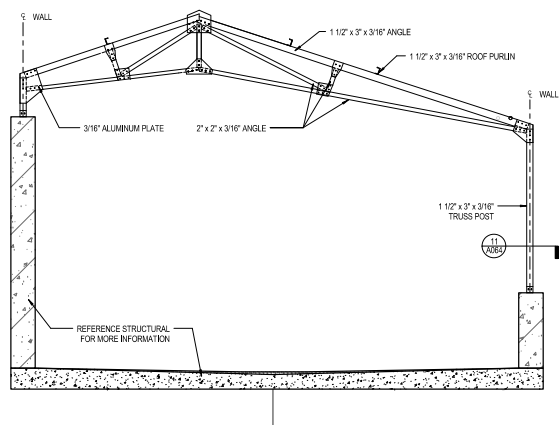


13 SECTION AT TRUSS ASSEMBLY
1/2" x 11'-0"

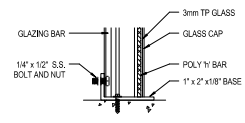


11 TRUSS POINT CLEAT DETAIL A
6" x 1'-0"

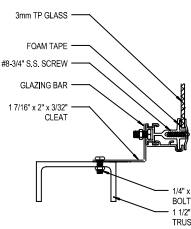


10 TRUSS POINT CLEAT DETAIL B
6" x 1'-0"

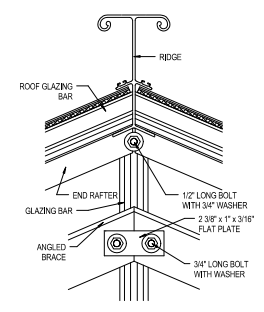

6 END RAFTER MITRE DETAIL
6" x 1'-0"

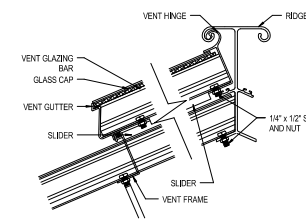

2 VENT AND RIDGE DETAIL
6" x 1'-0"

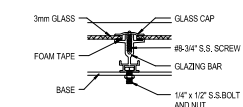

GLAZING BAR
6" x 1'-0"

NO.	DESCRIPTION	DATE

DESIGNED BY: HGA
DRAWN BY: HGA
CHECKED BY: HGA
HGA NO.: 3584-001-00

**GREENHOUSE
DETAILS**

DATE: JULY 06, 2017

DATE PLOTTED: 2/28/2017 10:58:58 AM

Attachment 4

**PRE-BID CLARIFICATION ("PBC") FORM
(ALL questions to be submitted on this form ONLY)**

PBC # **69**
(RSCCD USE ONLY):

PROJECT NAME:	RFP #1718-173 Science Center at Santa Ana College		
PROJECT NUMBER:	3049	DSA NUMBER:	04-115788
TO:	Allison Coburn	EMAIL:	Coburn_Allison@rsccd.edu

DATE:	August 7th, 2017		
FROM:	Luis Giordano McCarthy Building Companies	EMAIL:	lgiordano@mccarthy.com

SPECIFICATION NUMBER:	032000; 031500; 031100	DRAWING NUMBER:	
-----------------------	------------------------	-----------------	--

REQUESTED CLARIFICATION:

Specification Section 031500 – Concrete Accessories references Related Section 032000 Concrete Reinforcing (031500-1.1B.2), however this Specification Section is not provided. Also Section 031500-3.1A indicates to install concrete accessories and related materials as specified in Section 031100 – Concrete Formwork and this specification is also not provided. Please provide both missing specifications.

RESPONSE TO CLARIFICATION, SUBMITTED AS PART OF AN ADDENDUM:

Specification Sections 031100 and 032000 are not included in this package, as the information for reinforcing and formwork is included in Section 033000.

Forthcoming Addendum 2 will correct the incorrect spec section references noted above.

RESPONSE PROVIDED BY:	Stacy Kwok/ HGA	DATE:	8/31/17
-----------------------	-----------------	-------	---------

Attach additional numbered sheets as necessary; however, only one (1) request shall be contained on each submitted form.

Attachment 4

**PRE-BID CLARIFICATION ("PBC") FORM
(ALL questions to be submitted on this form ONLY)**

PBC # **70**
(RSCCD USE ONLY):

PROJECT NAME:	RFP #1718-173 Science Center at Santa Ana College		
PROJECT NUMBER:	3049	DSA NUMBER:	04-115788
TO:	Allison Coburn	EMAIL:	Coburn_Allison@rsccd.edu

DATE:	8/25/2017		
FROM:	John Modena, CW Driver	EMAIL:	jmodena@cwdriver.com
SPECIFICATION NUMBER:	RFP	DRAWING NUMBER:	

REQUESTED CLARIFICATION:

RFP paragraph 2.1. District's Evaluation: Methodology and Approach section states there will be 80 possible points allotted towards the "Firm's approach and methodology for construction services" yet there is no reference to this being required in the Attachment 6 "Required GMP Template Workbook". Is the Firm's Methodology and Approach required as part of the Contents of the Proposal submittal? If yes, please advise what tab this falls under:

RESPONSE TO CLARIFICATION, SUBMITTED AS PART OF AN ADDENDUM:

Methodology and Approach may be summarized at the beginning of TAB A separate from the GMP Template Workbook.

RESPONSE PROVIDED BY:	Allison Coburn	DATE:	8/30/17
-----------------------	----------------	-------	---------

Attach additional numbered sheets as necessary; however, only one (1) request shall be contained on each submitted form.

Attachment 4

**PRE-BID CLARIFICATION ("PBC") FORM
(ALL questions to be submitted on this form ONLY)**

PBC # **71**
(RSCCD USE ONLY):

PROJECT NAME:	RFP #1718-173 Science Center at Santa Ana College		
PROJECT NUMBER:	3049	DSA NUMBER:	04-115788
TO:	Allison Coburn	EMAIL:	Coburn_Allison@rsccd.edu

DATE:	8/25/2017		
FROM:	John Modena, CW Driver	EMAIL:	jmodena@cwdriver.com
SPECIFICATION NUMBER:	RFP	DRAWING NUMBER:	

REQUESTED CLARIFICATION:

Page 5, paragraph 1.2 (Tab B) Contractor's Subcontractors. The description of this tab refers to Attachment 3, which is the "Subcontractor Procurement Process" that all Contractor's shall follow.
The List of Subcontractors is currently part of Attachment 5, which is required under Tab D: Additional Forms.
It doesn't look like any information needs to be provided for tab B. We are under the assumption that this tab will not be used to list the Designated Subcontractors. Please clarify what information is to be provided under Tab B:

RESPONSE TO CLARIFICATION, SUBMITTED AS PART OF AN ADDENDUM:

TAB B shall be where the Contractor indicates that they have adhered to the process described in Attachment 3. The listing of subcontractors as Attachment 5 shall be provided in proposal under TAB D.

RESPONSE PROVIDED BY:	Allison Coburn	DATE:	8/30/17
-----------------------	----------------	-------	---------

Attach additional numbered sheets as necessary; however, only one (1) request shall be contained on each submitted form.

Attachment 4

**PRE-BID CLARIFICATION ("PBC") FORM
(ALL questions to be submitted on this form ONLY)**

PBC #
(RSCCD USE ONLY):

72

PROJECT NAME:	RFP #1718-173 Science Center at Santa Ana College		
PROJECT NUMBER:	3049	DSA NUMBER:	04-115788
TO:	Allison Coburn	EMAIL:	Coburn_Allison@rsccd.edu

DATE:	8/25/2017		
FROM:	John Modena, CW Driver	EMAIL:	jmodena@cwdriver.com
SPECIFICATION NUMBER:	RFP	DRAWING NUMBER:	

REQUESTED CLARIFICATION:

Page 2, under "Proposals" states that the "Firm's response shall not exceed sixty (60) pages." Does this count include the Workbook tabs?

RESPONSE TO CLARIFICATION, SUBMITTED AS PART OF AN ADDENDUM:

The 60 page count may exclude the GMP Workbook tab.

RESPONSE PROVIDED BY:	Allison Coburn	DATE:	8/30/17
-----------------------	----------------	-------	---------

Attach additional numbered sheets as necessary; however, only one (1) request shall be contained on each submitted form.